


818,000.000

15

2,215,000.000

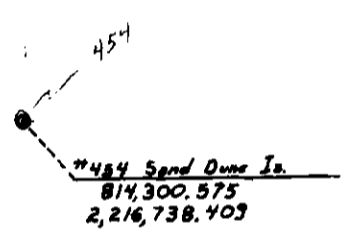

2,220,000

2,222,000

814,000

ENG - WASH
UMATILLA NWR
Scale 1" = 400'
July 1973

c-3K^{3A}

C-3K-556

810,000