


818,000 N

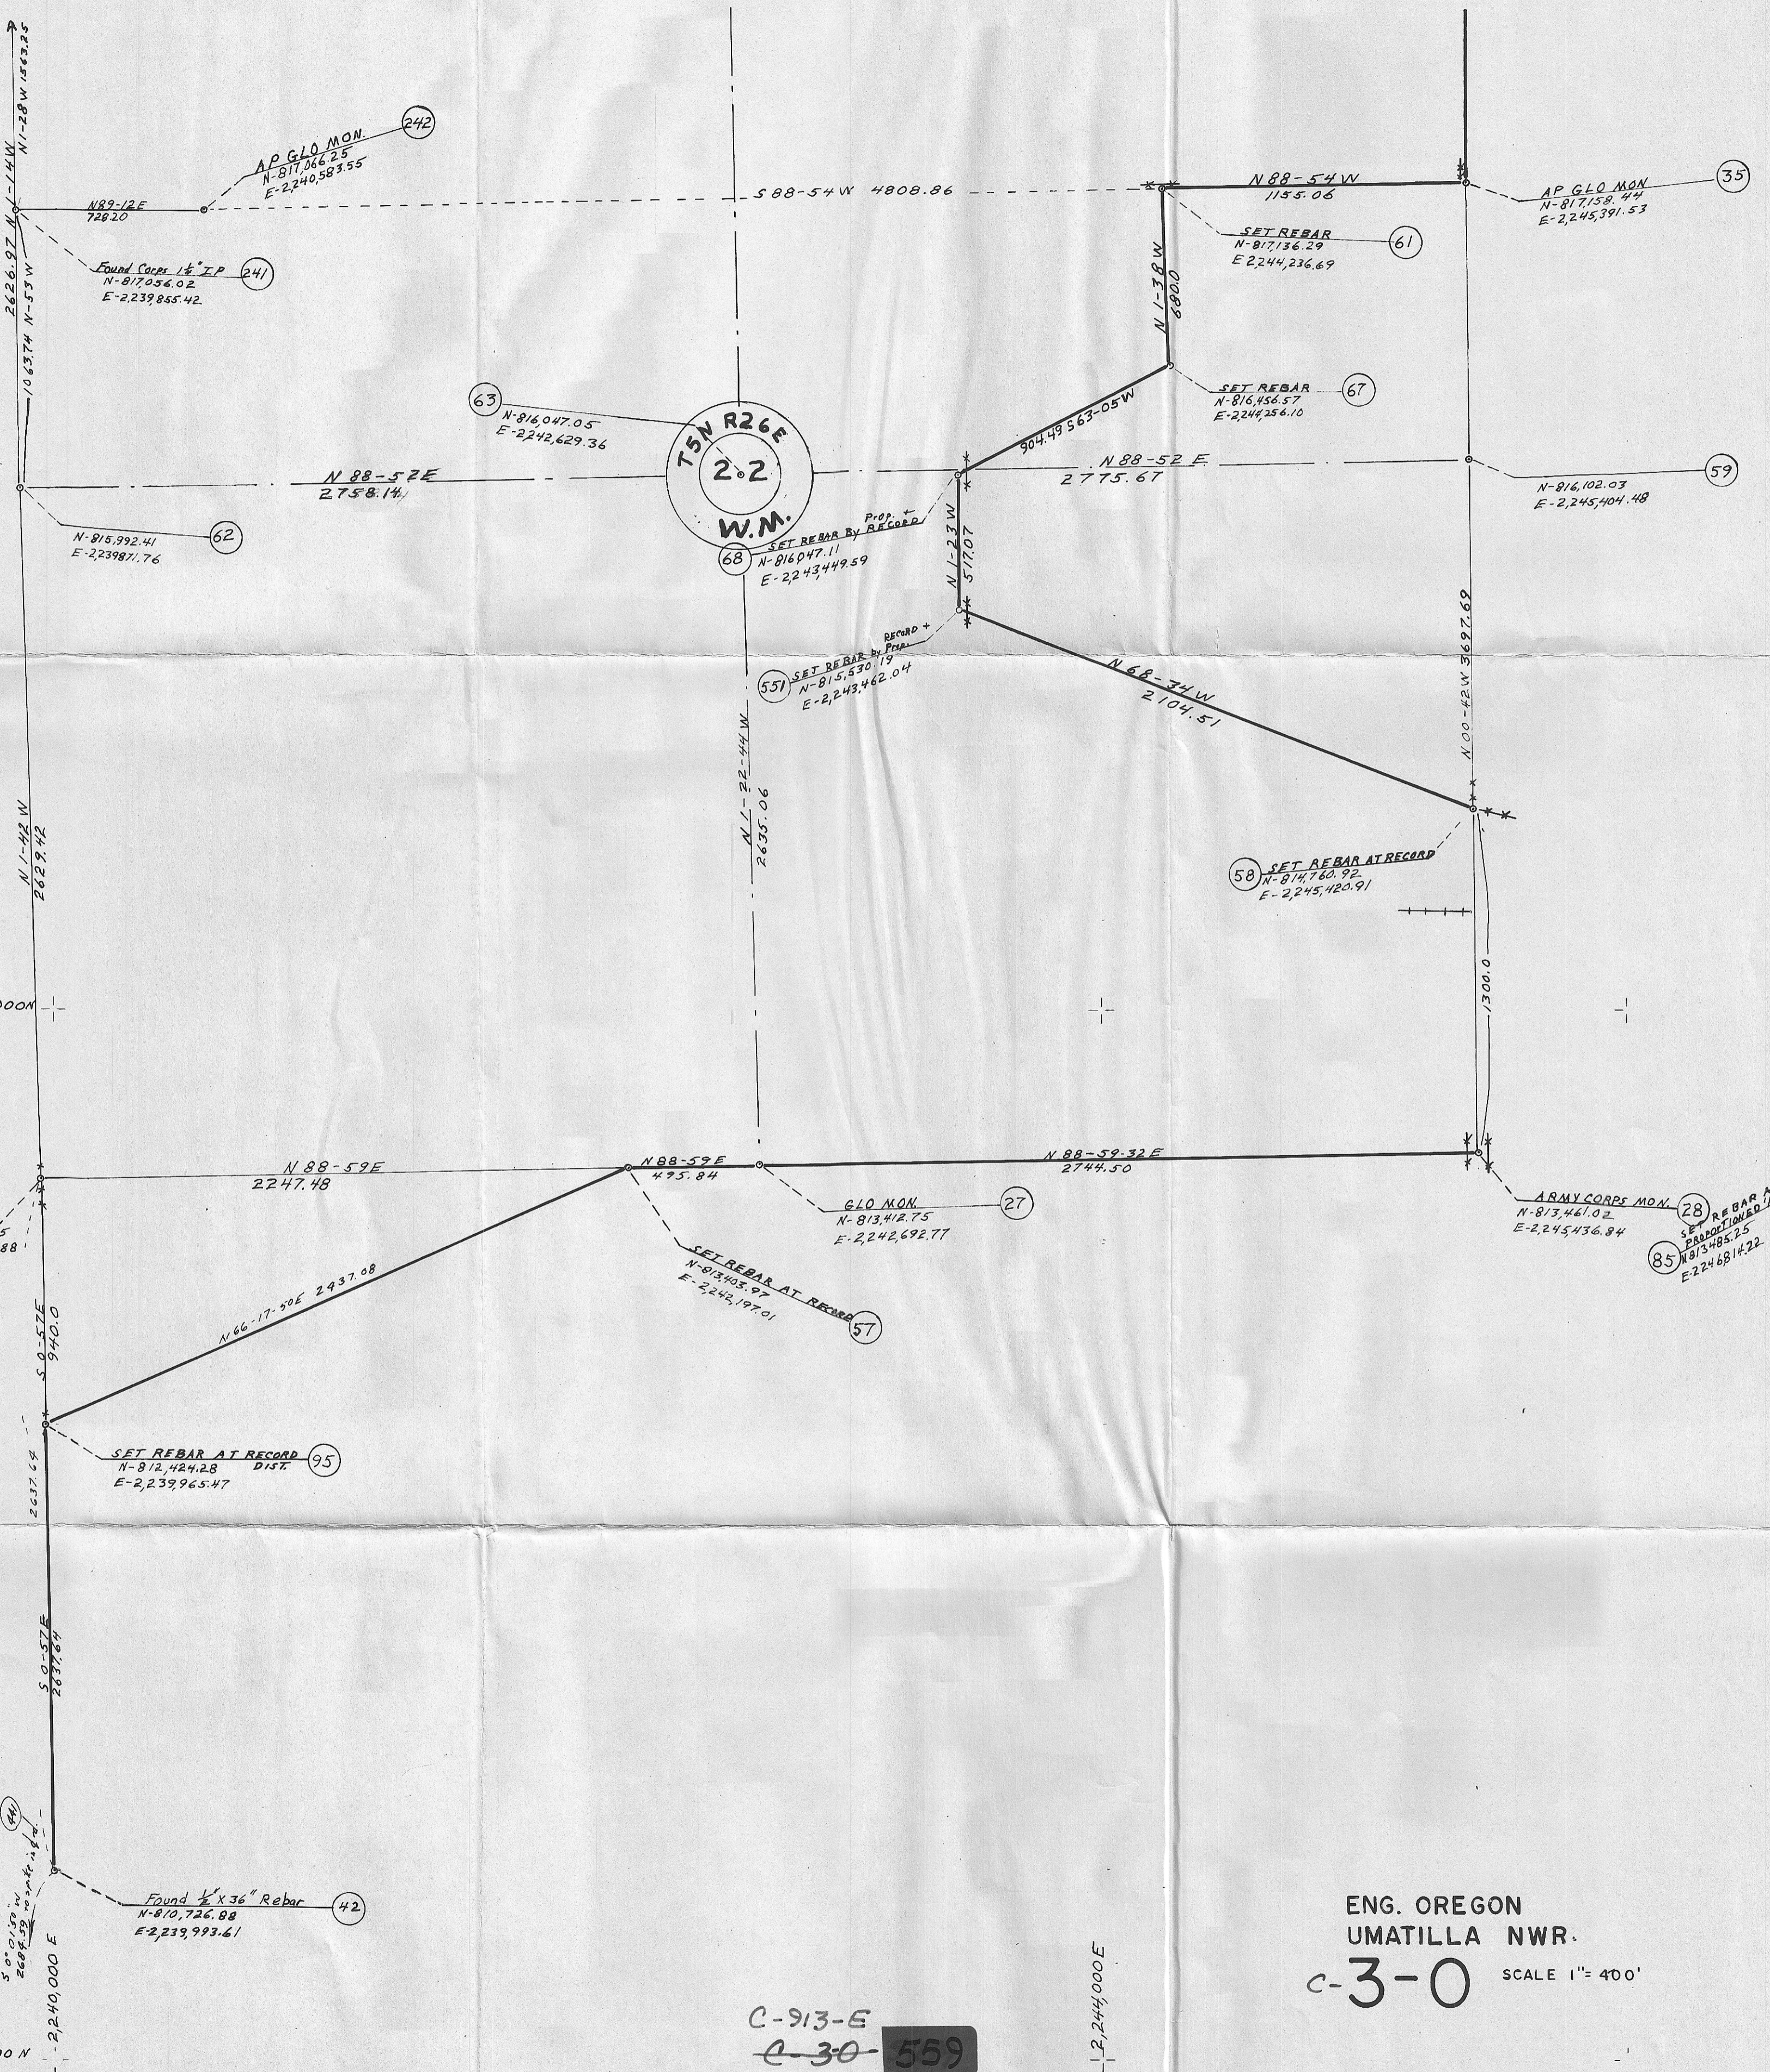

814,000 N

810,000 N

2,244,000 E

ENG. OREGON
 UMATILLA NWR.
 C-3-0 SCALE 1"=400'

C-913-E
 C-30-559