

794,000 N
E-189,000


794,000 N

E-184,000

790,000 N

790,000 N

C-915-E-561

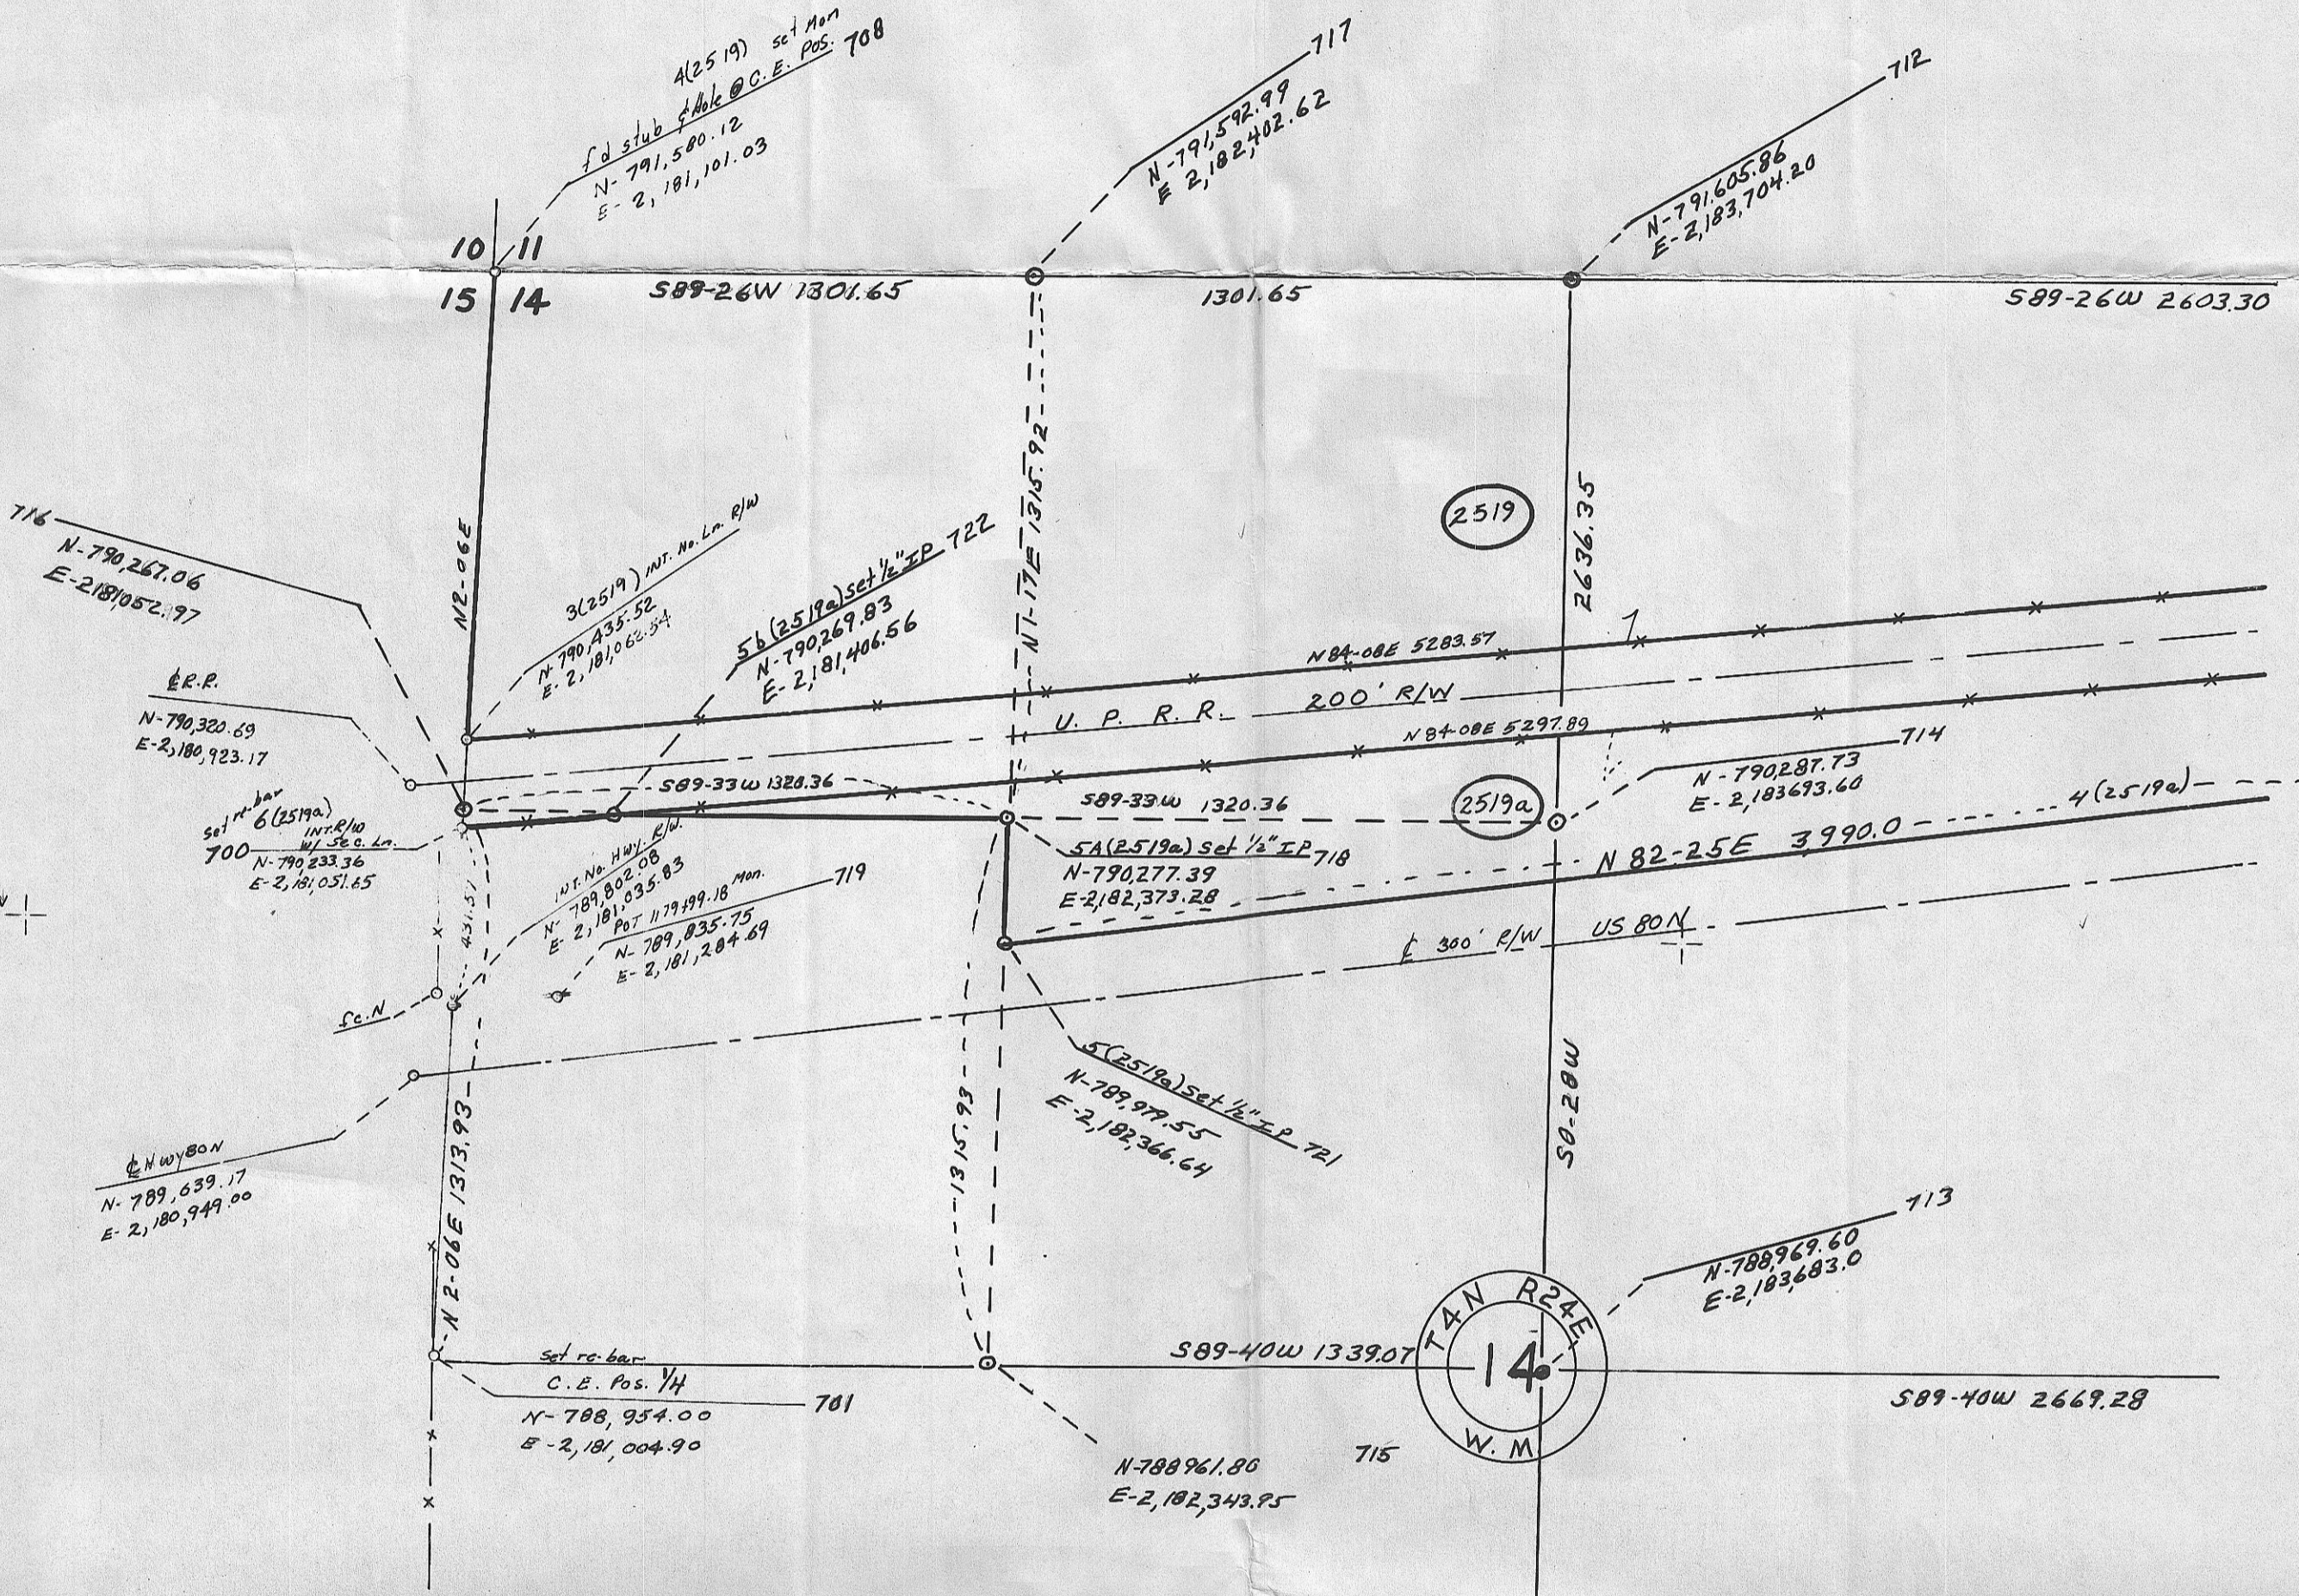

ENG - OREGON
 UMATILLA
 C-6D
 1" = 400'

C-915-E
 C-6D-561

786,000 N
 E-189,000

786,000 N

E-184,000