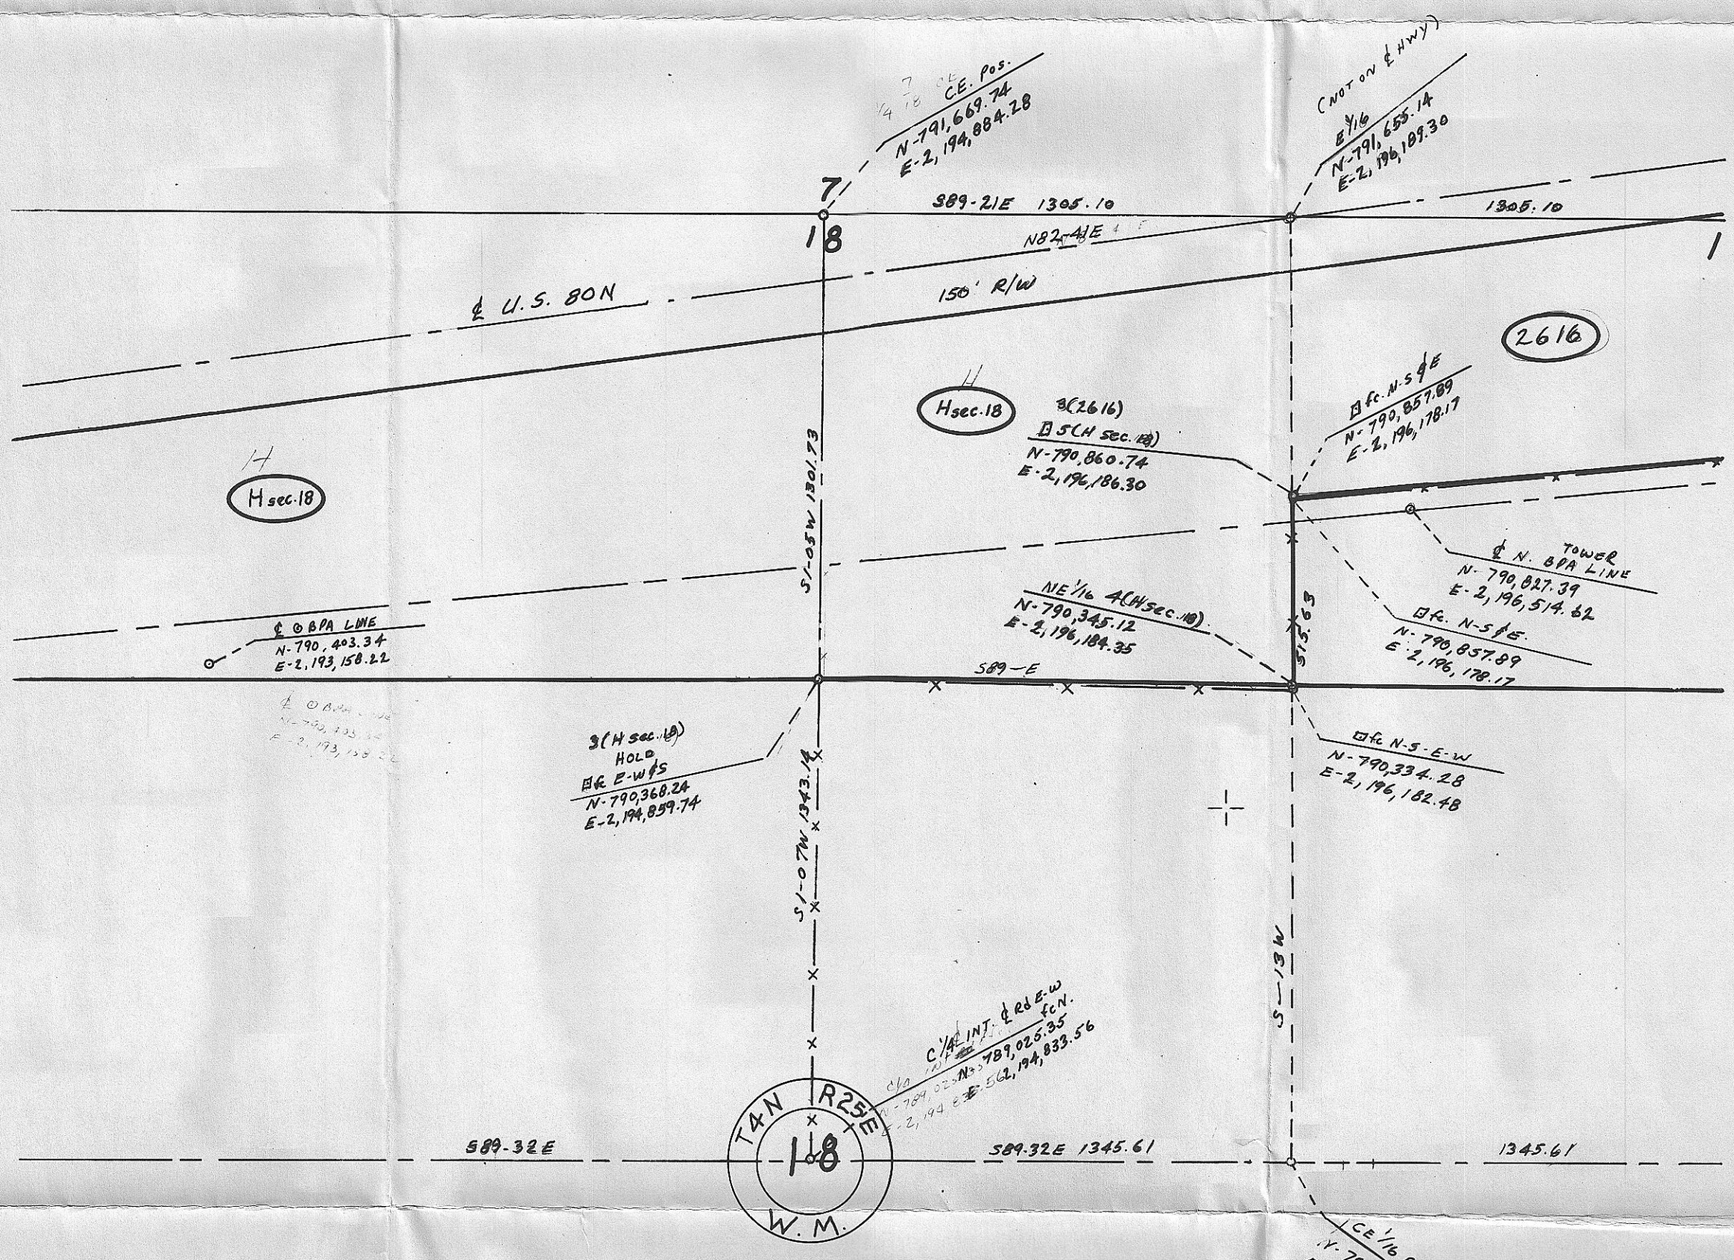

786,000

C-917-E
~~C-6F~~ 563

E-2,196,000

ENG-OREGON
UMATILLA

C-6F

1"=400'

786