

Nail in 3" Fir Stump
R.P. PI 13
N 5° 53' E
37.55

$\Delta = 22^{\circ} 10' 32''$
R = 533.9
T = 103.8
L = 205.1
E = 10.0

$\Delta = 12^{\circ} 29' 16''$
R = 832.0
T = 91.0
L = 181.3
E = 5.0

Nail in 25" Pine Stump
R.P. PI 13
N 66° 06' E
33.23

$\Delta = 17^{\circ} 15' 24''$
R = 837.4
T = 127.1
L = 252.2
E = 10.0

$\Delta = 16^{\circ} 35' 06''$
R = 568.0
T = 82.8
L = 164.6
E = 6.0


$\Delta = 5^{\circ} 53' 57''$
R = 3768.2
T = 194.2
L = 388.0
E = 5.0

$\Delta = 25^{\circ} 29' 36''$
R = 1024.5
T = 241.2
L = 473.7
E = 28.0

Nail in 6" Alder
R.P. PI 17
S 62° 02' W
37.91

Nail in 6" Alder
R.P. PI 17
S 17° 57' E
51.48

SECTION 33
SECTION 34

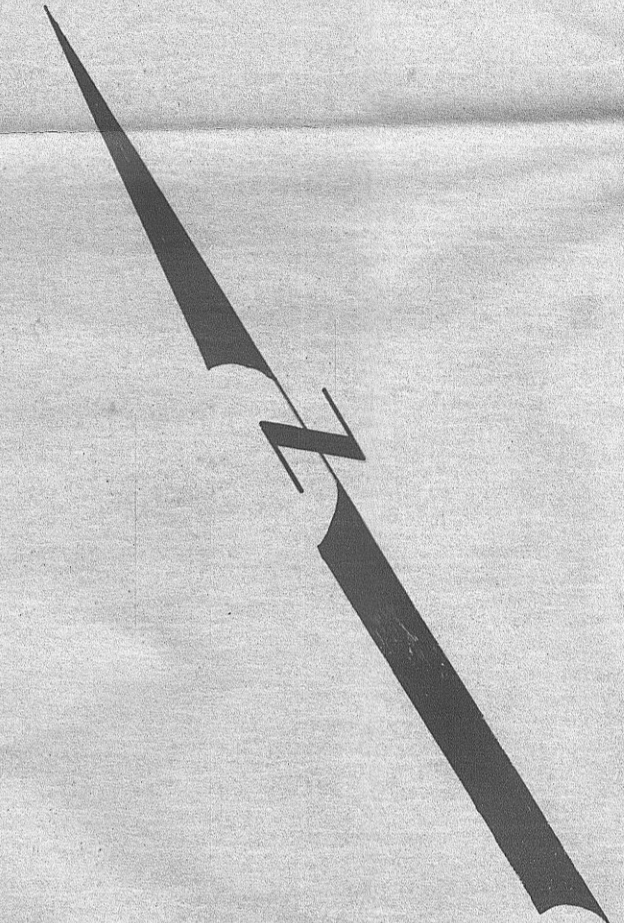

$\Delta = 30^{\circ} 00' 48''$
R = 995.2
T = 105.9
L = 207.6
E = 14.6

$\Delta = 48^{\circ} 01' 08''$
R = 264.0
T = 117.6
L = 221.2
E = 25.0

$\Delta = 13^{\circ} 24' 12''$
R = 1454.3
T = 170.8
L = 340.2
E = 10.0

$\Delta = 19^{\circ} 17' 40''$
R = 557.8
T = 94.8
L = 187.8
E = 8.0

$\Delta = 8^{\circ} 02' 03''$
R = 2700.6
T = 189.6
L = 378.7
E = 6.7

Nail in 8" Aspin
R.P. PI 24
S 39° 46' W
99.03

$\Delta = 10^{\circ} 00' 11''$
R = 1308.9
T = 114.5
L = 228.5
E = 5.0

Nail in 12" Fir
R.P. PI 24
S 40° 30' E
144.20

BAGETT-GRIFFITH-FERGUSON
John Day, Oregon
MAP OF SURVEY
NORTH FORK WILLOW CREEK ROAD
RIGHT OF WAY MAP
SECTIONS 29, 28, 34 T35 R28E W.M.
SECTIONS 3, 2 T45 R28E W.M.
MORROW COUNTY, OREGON

SURVEYED FOR: MORROW COUNTY ROAD DEPT.
SURVEYED BY: D.I.G. & D.M.F. Sept. 1970
Scale: 1" = 100' Drawn by: T.D.G. Sept. 1970

REGISTERED
OREGON
LAND SURVEYOR
Duane I. Griffith
JULY 10, 1964
DUANE I. GRIFFITH
644

SHEET 2 OF 4 SHEETS

D-2-K-570

Robert D. Baggett
Morrow County Surveyor

D-2-K (570)

D-2-K
(570)