D-2-K (573)

MAP OF SURVEY

Morrow County Road Department
North Fork Willow Creek Road

IN

T3 & 4S R28E W.M.

SURVEYED IN SEPTEMBER 1970
BY
BAGETT - GRIFFITH - FERGUSON

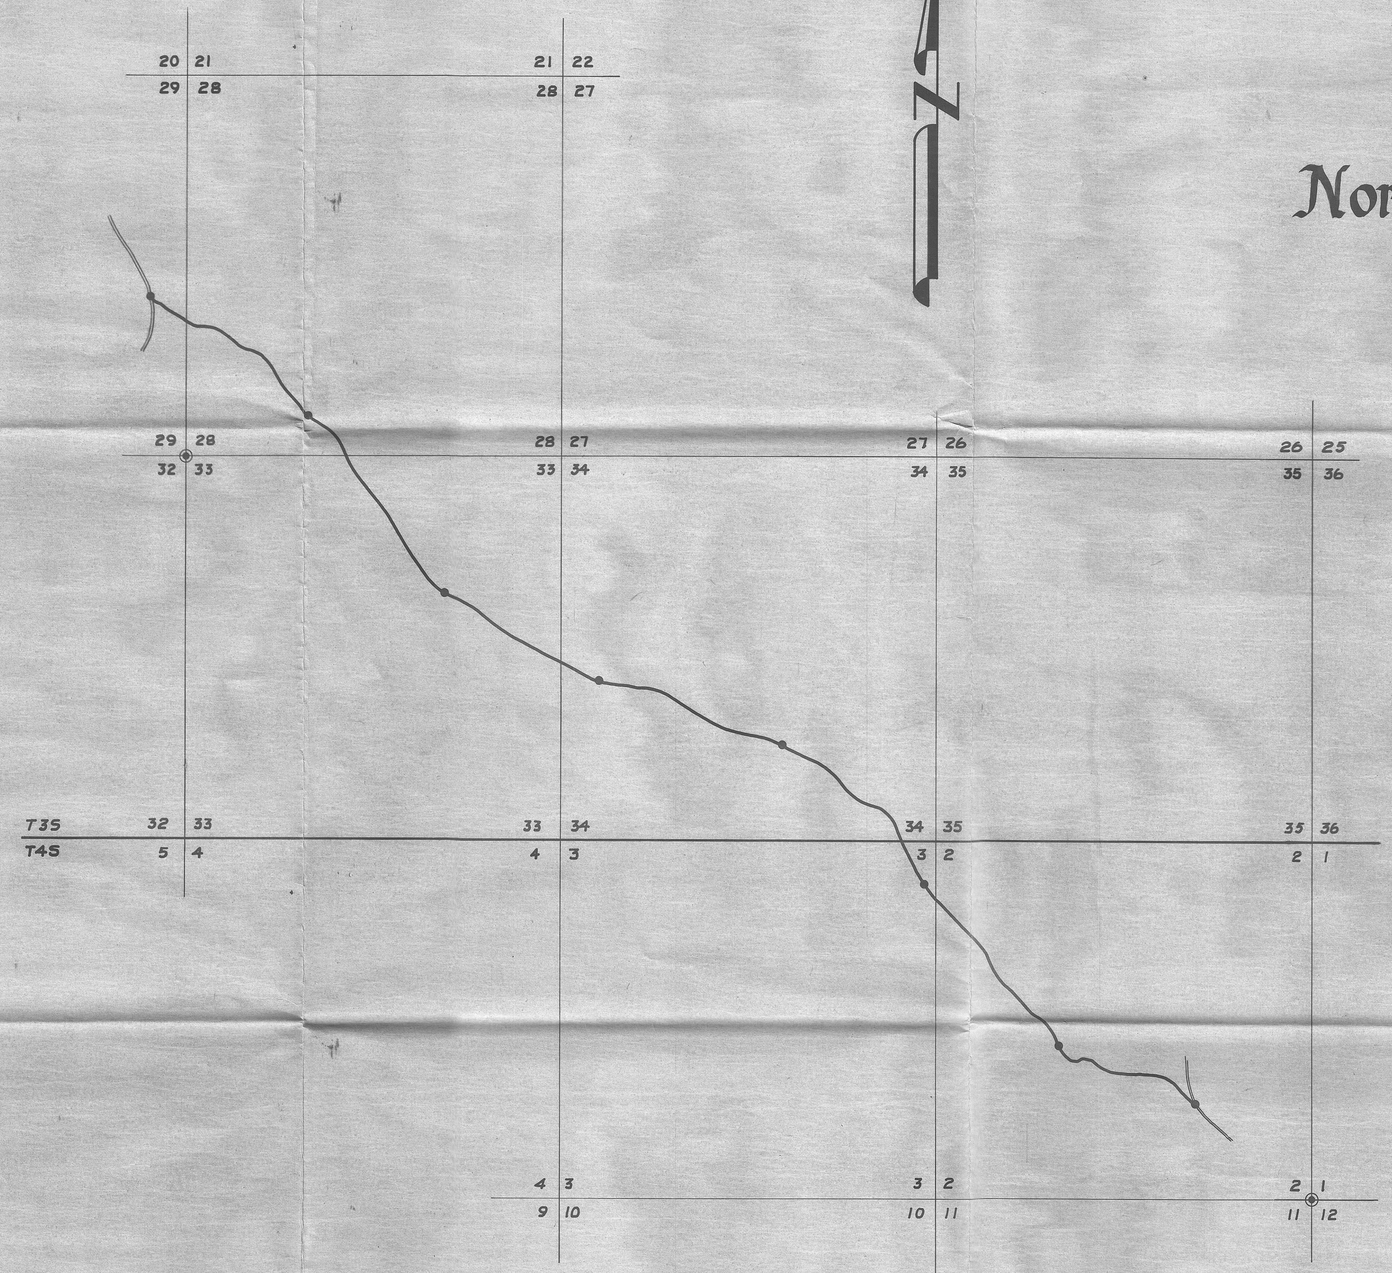

LEGEND

- PI's which were referenced
- Section Corners tied
- Existing Roads

Albert D. Bagett
Morrow County Surveyor

INDEX SHEET

D-2-K-573

D-2-K
573