

D-187-K-584

57610

N. 89° 42' 38" E
Fence

OLD
Fence Cor.

AREA MAP

SEC. 26

SCALE 1"=1000'


234.19 ACRES

LEGEND

● Denotes 5/8" Iron pin Set

NOTE

Bearing based on sun shot
taken by R. THOMPSON on
February 1975

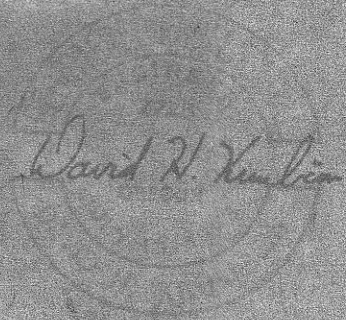

SURVEY FOR
CAMPBELL & TUCKER
PARCEL IN E. 1/2 SEC. 26 T2N, R26E, W.M.

WAYNE HARRIS CO. INC.
ENGINEERS-SURVEYORS-REDFORD, OREGON
SCALE 1"=200' DRN BY 74 DRNG NO.
DATE 2/25/75 CKD BY DWK 175-4450

D-187-K-584-76