


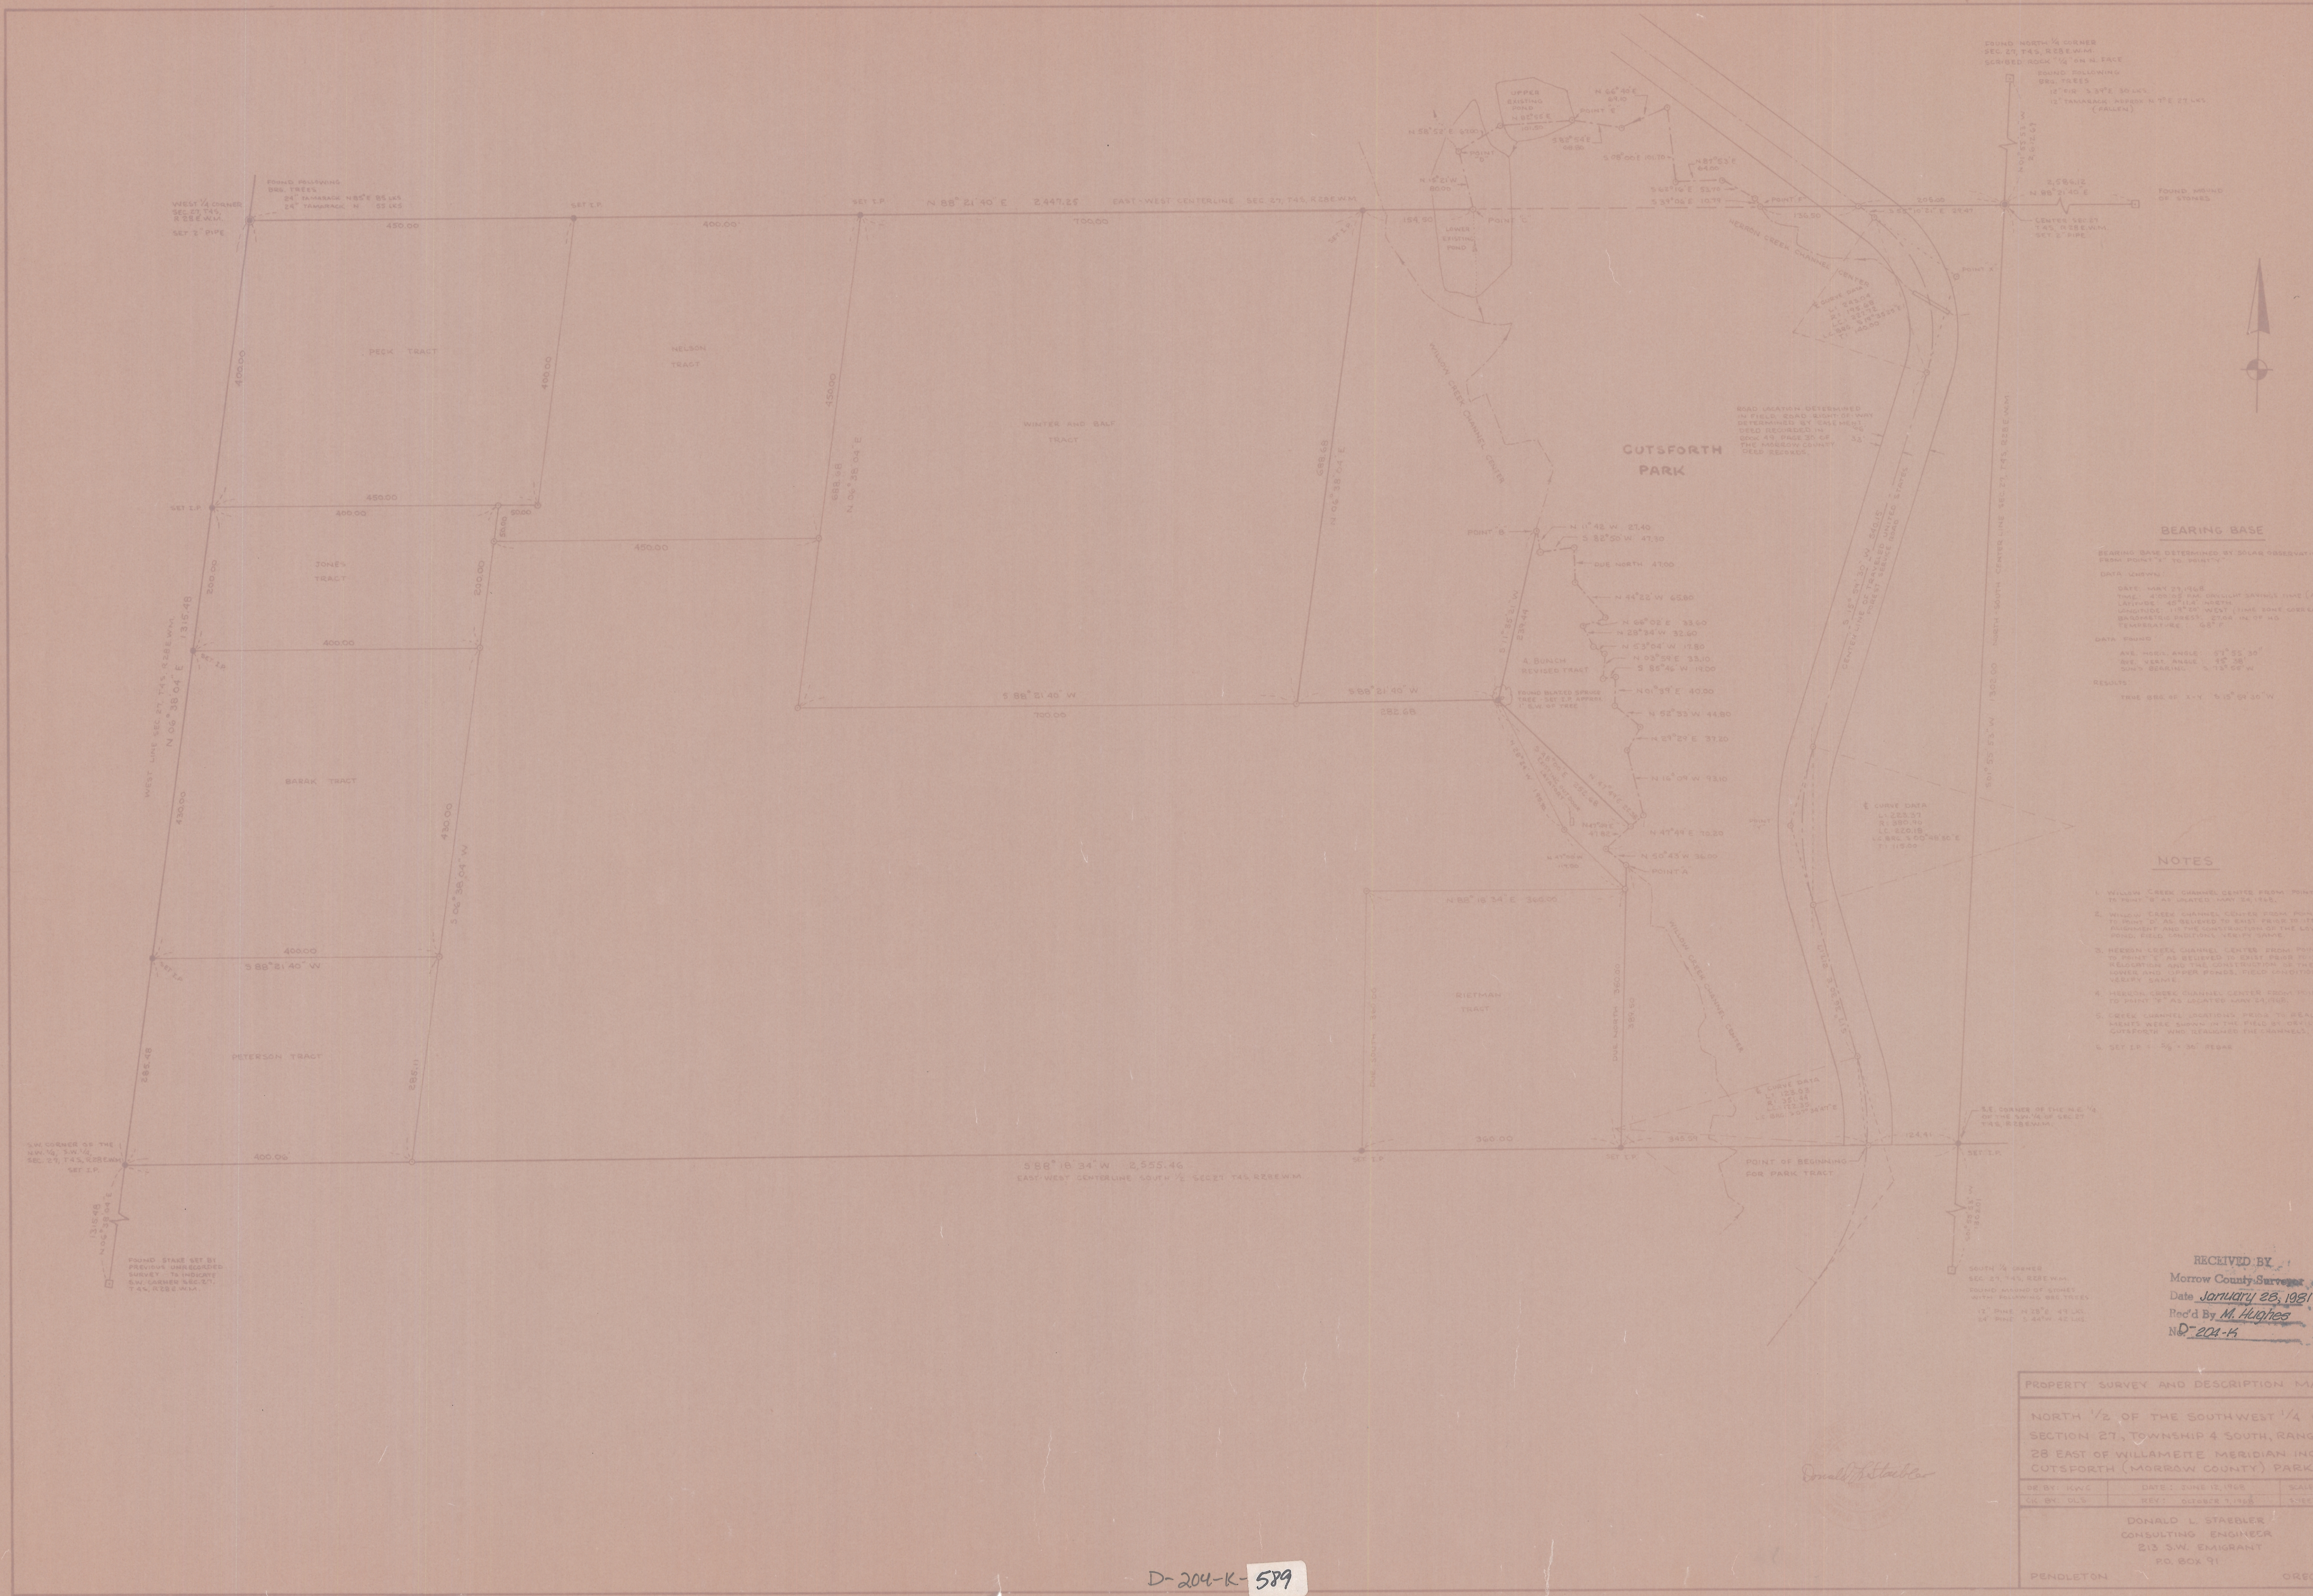

D-204-K-589

PROPERTY SURVEY AND DESCRIPTION MAP		
NORTH 1/2 OF THE SOUTHWEST 1/4 OF SECTION 27, TOWNSHIP 4 SOUTH, RANGE 28 EAST OF WILLAMETTE MERIDIAN INCLUDING CUTSFORTH (MORROW COUNTY) PARK		
BY: J.W.C.	DATE: JUNE 12, 1980	SCALE: 1"=40'
BY: D.L.S.	REV: AUGUST 1, 1980	1"=40'
DONALD L. STAEBLER CONSULTING ENGINEER 213 S.W. EMIGRANT RD. BOX 91 PENDLETON OREGON		