


RECORD OF SURVEY

OF THE FORMER OWRR & NAV CO. RIGHT OF WAY
IN SECTION 24, T5N, R26E, W.M.,
MORROW COUNTY, OREGON

SWIFT SUBDIVISION SURVEY, 1976

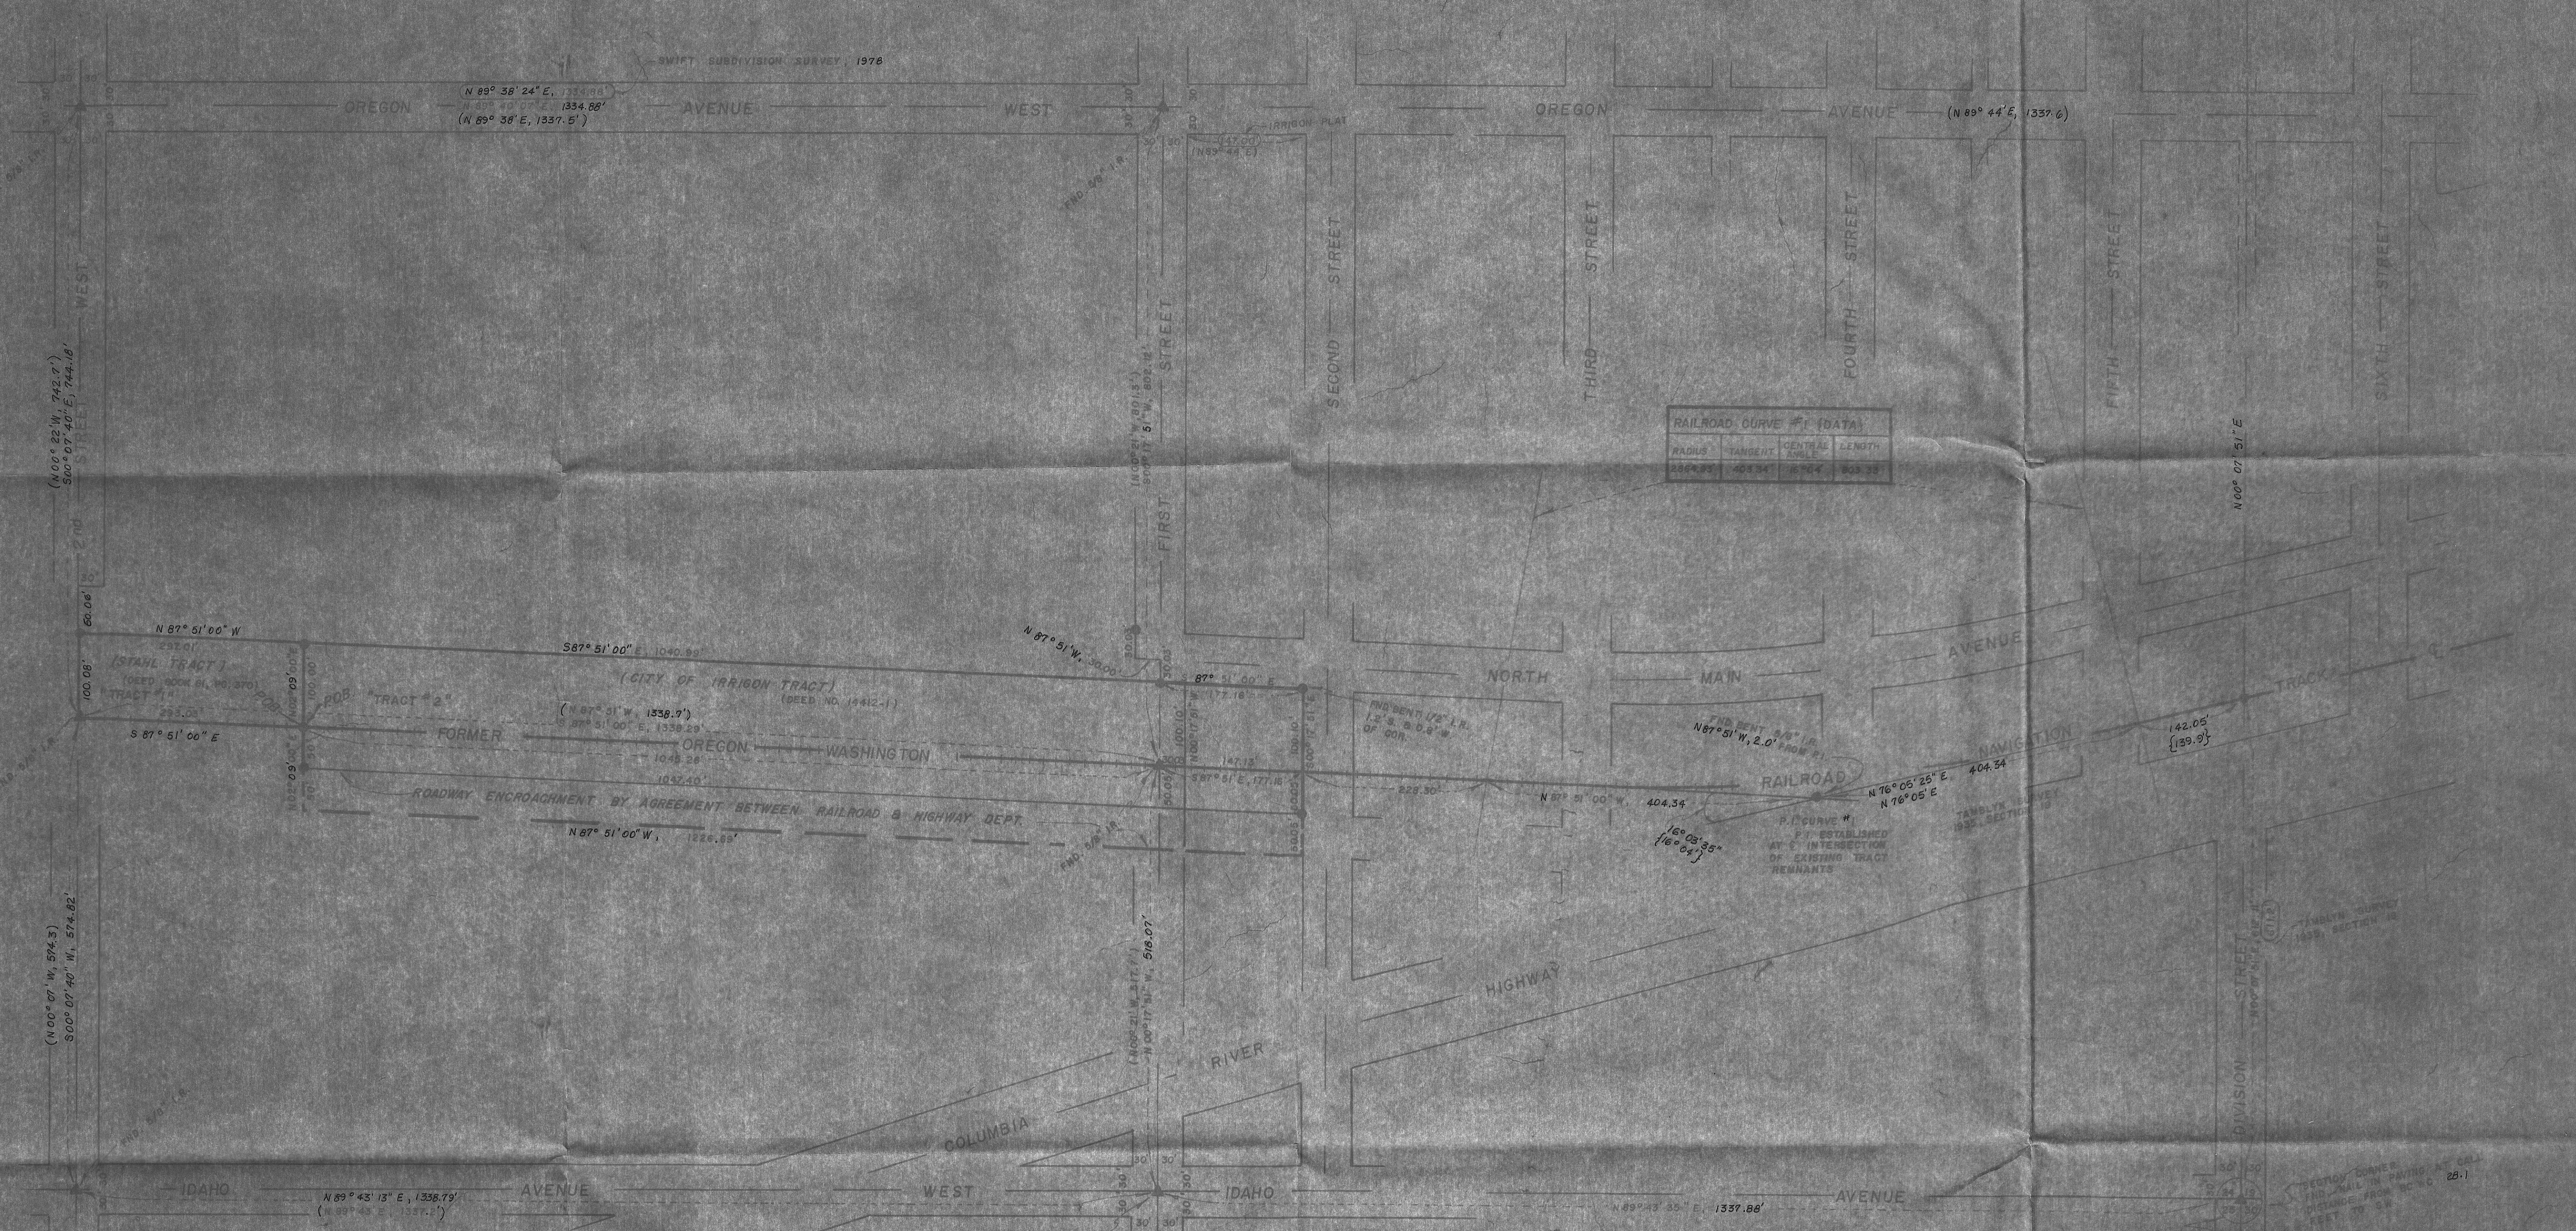

RAILROAD CURVE #1 (DATA)			
RADIUS	TANGENT	CENTRAL ANGLE	LENGTH
2864.33	403.34	16°05'35"	803.38

REFERENCES

- QUITCLAIM DEED FROM UNION PACIFIC RAILROAD TO JOHN C. SWEARINGEN ET AL, RECORDED JANUARY 10, 1927, BOOK 81, PAGE 370, MORROW COUNTY RECORDS.
- AGREEMENT BETWEEN OREGON-WASHINGTON RAILROAD, IRRIWON CO., UNION PACIFIC RAILROAD AND THE OREGON STATE HIGHWAY COMMISSION, RECORDED APRIL 21, 1972, M.F. 2-1303, MORROW COUNTY RECORDS.
- QUITCLAIM DEED FROM UNION PACIFIC RAILROAD TO THE CITY OF IRRIWON, UNRECORDED DOCUMENT, U.P.R.R. DEED NO. 14412-1.

SCALE: 1" = 100'

BASIS OF BEARING

CENTERLINE TRACK ALIGNMENT BETWEEN FIRST STREET & SECOND STREET WEST BEARS N 87° 51' 00" W PER TAMBLYN SURVEY.

LEGEND

- SURVEY DATA AS NOTED
- DEED CALLS SHOWN IN QUITCLAIM DEED - 14412-1 FROM U.P.R.R. TO CITY OF IRRIWON
- TAMBLYN SURVEY 1925, SECTION 24
- KROMBEIN SURVEY 1973
- SET 5/8" x 30" IRON ROD
- FOUND MONUMENT AS NOTED

DESCRIPTIONS

TRAC #1




D-224-K-591

REGISTERED PROFESSIONAL LAND SURVEYOR
THOMAS F. LAGLER
SEP 23 1970

RECORD OF SURVEY
PREPARED FOR: JOEL S. MORSE, JR.
TELER ENGINEERING
1540 SW 11TH STREET
HERMISTON, OREGON 97131

RECEIVED BY
Morrow County Surveyor
Date 4/16/79
SLB
D-224-K 591

5/79 1"=100'