

BASIS OF BEARING

Solar observation taken at a point 1581.57 feet North and 3316.26 feet East of the South 1/4 corner of section 18 Township 4 South, Range 29 East of the Willamette Meridian.

Date	6-28-89
Latitude	45°13'10"
Longitude	119°14'50"
Time	16:42:00
Magnetic Declination	17° East

LEGEND

- Found brass cap monument set by others. See history of survey.
- ⊙ Found original GLO Survey evidence and set 2 1/2" x 30" aluminum monument.
- ⊙ Set 2 1/2" x 30" aluminum monument at position determined by survey.
- National Forest boundary posted to standard.
- P Privately owned land
- NF National Forest land
- () Record information of GLO contract no. 417, by Edward W. Sanderson.
- [] Record information of GLO contract no. 507, by Frank W. Campbell.
- [] Record information of survey done by Duane I. Griffith PLS 644, dated 11-75.
- [] Record information of survey done by Thomas H. Hanson PLS 1058.

NOTE: For monumentation information, see monumentation sheets filed separately.

HISTORY OF SURVEYS

The exterior and interior lines of Township 4 South Range 28 and 29 East of the Willamette Meridian was retraced by Edward W. Sanderson, contract number 417 dated August 24, 1881.

The East Range line of Township 4 South Range 28 East of the Willamette Meridian was retraced by Frank W. Campbell, contract number 507, dated June 28, 1884.

The North 1/4 corner of section 17 was monumented by survey by Duane I. Griffith PLS 644 in 11-75.

The Northeast corner, the Southeast corner, the South 1/4 corner of section 18, and the South 1/4 corner of section 17 were monumented from original GLO Survey evidence by Craig L. Wanless BLM, Group number 350 in 9-77. Under instructions dated May 3, 1957.

The South 1/4 corner of section 17 was monumented from the new bearing lines as established by Craig L. Wanless BLM, in 9-77, by Douglas M. Ferguson PLS 848 in 10-81.

The Southeast corner of section 12 Township 4 South Range 28 East was monumented from original GLO Survey evidence by David H. Krumbain PLS 933 in 10-83.


The section line between the South 1/4 corner of section 18 and the Southeast corner of section 18 was retraced by Thomas M. Hansen PLS 1058, dated November, 1986.

SURVEYOR'S STATEMENT

I, Duane I. Griffith registered land surveyor in the State of Oregon hereby certify that this plot and notes hereon, or attached are a true and correct representation of the survey made in July 1989 at the request of USDA Forest Service in accordance with the statutes of the State of Oregon and with the articles of my contract.

I retraced the area as shown on the annexed map. Most of the corners had been found and monumented by others. See History of Surveys, hereon. The 1/4 corner to sections 17 and 18 was searched, the proportionate position is at the toe of a Forest Service road. No evidence was found. Sanderson's notes running North between sections 17 and 18 call the brook at 33.75 chains. This appears to be an error, probably 5 chains. The brook is at 34.95 chains. The rest of the topo calls fit very well. The north 1/4 corner of section 18 was found as indicated. Sanderson's calls to the range line are phony! The relationship between the North 1/4 corner and the South 1/4 corner of section 18 indicate he probably did not close to the range line as he states. The topo calls do not fit either. I find no other unusual conditions on this survey.


Duane I. Griffith
 Duane I. Griffith, OPLS 644
 Baggett, Griffith and Associates
 2006 Adams Avenue
 LaGrande, Oregon
 July 27, 1989

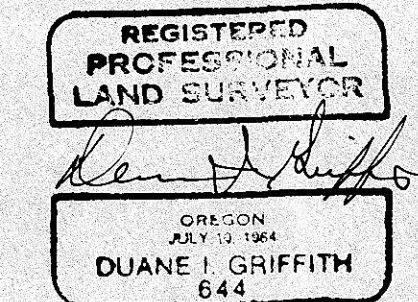

NATIONAL FOREST LANDS

- Township 4 South Range 28 East
 - Section 13
 - The Northeast 1/4
- Township 4 South Range 29 East
 - Section 17
 - The West 1/2
 - Section 18
 - The South 1/2
 - The Southeast 1/4 of the Northwest 1/4
 - The South 1/2 of the Northeast 1/4
 - The Northeast 1/4 of the Northeast 1/4

Scale 1" = 500'

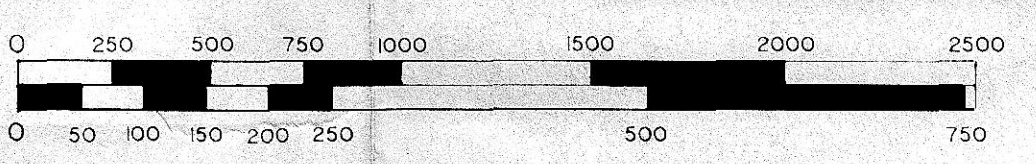

1 Meter = 3.2808333 Feet

The information within these boxes is for U.S. Forest Service record keeping purposes only

PROJECT NAME Salsbury Cadastral Survey	Examined and accepted for the U.S. Forest Service this <u>28</u> day of <u>August</u> , 1989
CONTRACT NUMBER OO-04R3-9-14	<i>Devin Taylor</i> C.O.R.
FIELD BOOKS Traverse Book Numbers 4 and 5 Remonumentation Book Number 1	I certify that this survey was performed at the request of the Umatilla National Forest. NATIONAL FOREST SUPERVISOR <i>James A. Lawrence</i> SIGNATURE DATE <u>8-2-89</u>

RECEIVED BY
 Morrow County Surveyor
 Date 8/18/89
 Rec'd By DP
 No. D 888 E-6604

BAGETT - GRIFFITH & ASSOCIATES LaGrande, Oregon	
Map of Survey Location of National Forest boundaries located in sections 17 and 18 Township 4 South Range 29 East of the Willamette Meridian.	
MORROW COUNTY, OREGON	
SURVEYED FOR	Umatilla National Forest
SURVEYED BY	DIG
Scale: 1" = 500'	Drawn by: JPP
	7-89