



A-40-K

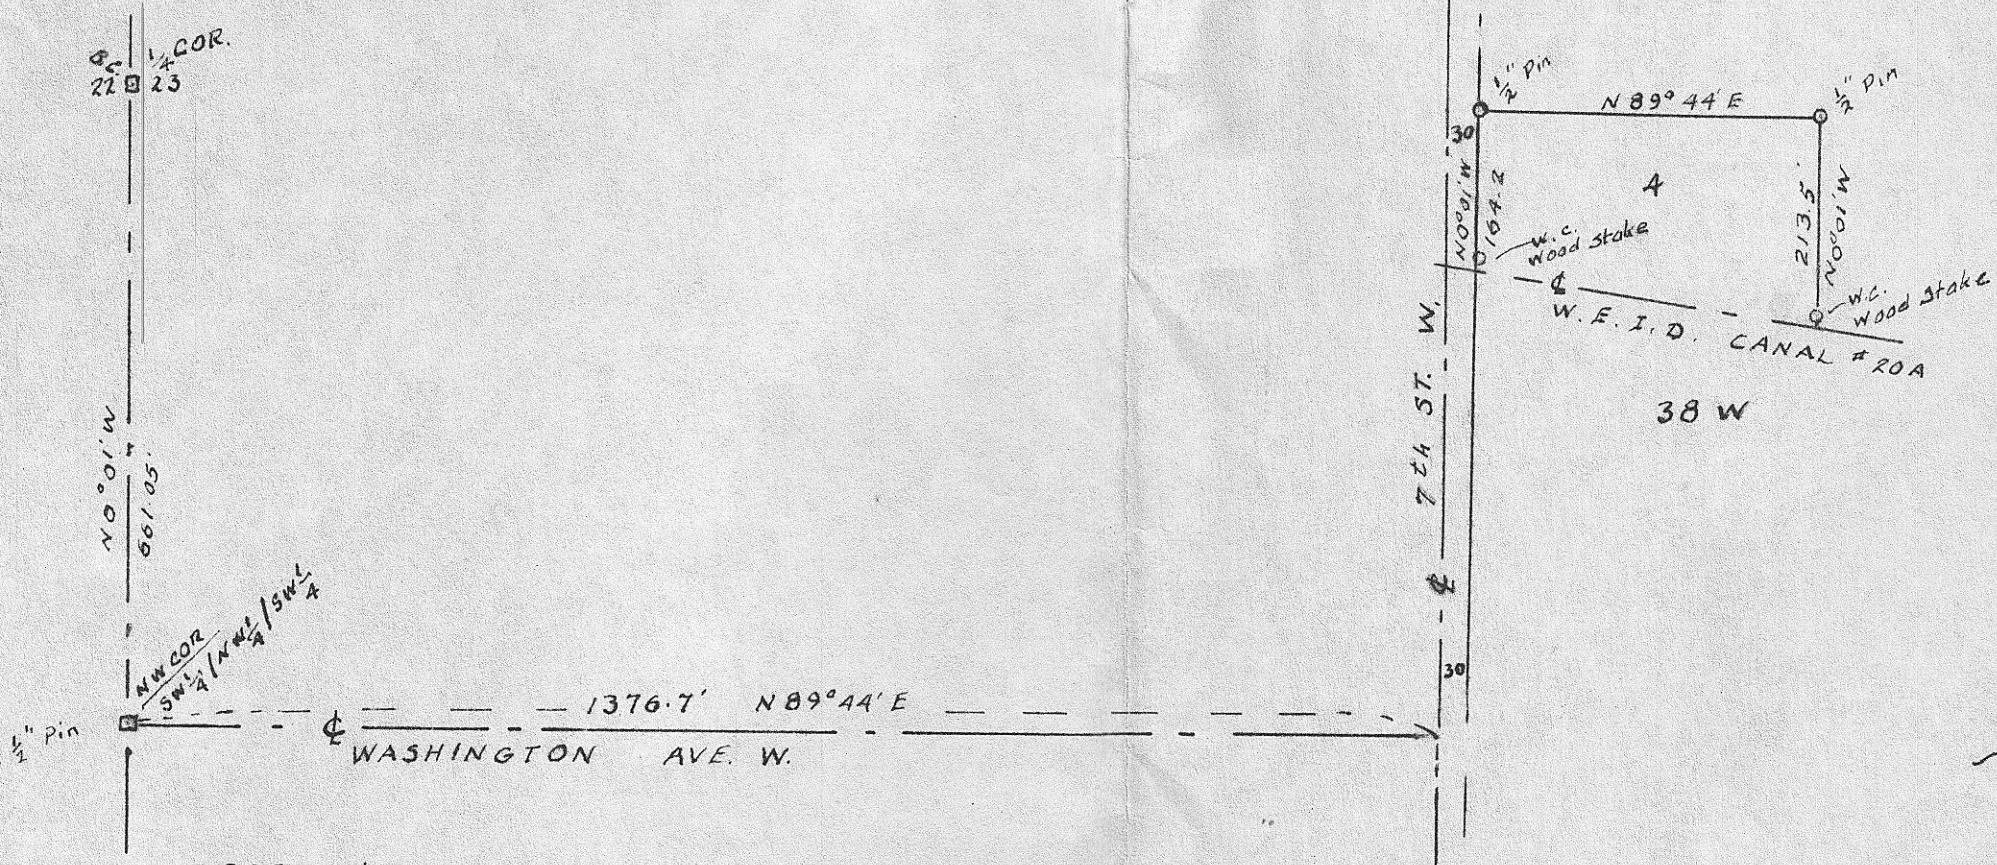

LEGEND:
 □ POINTS FOUND AS NOTED
 ○ POINTS SET AS NOTED
 BEARINGS AND DIMENSIONS BASED
 ON MORROW COUNTY ASSESSOR MAP 5N 26 23

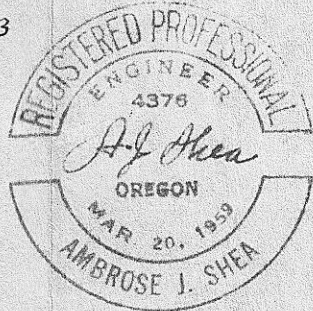

FOR JOE WOOD
 SURVEY PLAT OF PORTION OF
 LOT 4 BLOCK 38 W
 IN $NE \frac{1}{4} / SW \frac{1}{4}$ SEC 23, T5N, R26E, W.M.
 MORROW CO OR.
 SCALE 1" = 200'

693

A-40-K