


Ferguson Surveying

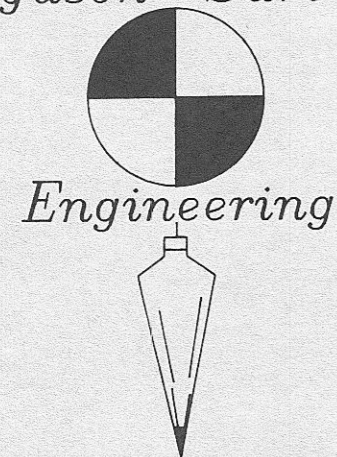

MT. VERNON, OREGON  
PHONE (503)932-4520  
FAX (503)932-4430

MONUMENTATION AND MAINTENANCE

See standard U.S.F.S. "INDEX No." in the circle on the map. Monuments are stamped as shown below. On each Bearing tree, nailed a brass washer stamped "PLS 848" blaze above the BT scribe and nailed warning signs on the back. Set steel posts with warning and boundary signs, on line within 5 ft. of property corners, or a single post with a warning sign within 5 ft. of controlling corners.

See "CERTIFIED RECORD OF LAND CORNER MONUMENTATION" forms on file in the office of the Morrow County Surveyor for a complete history, description of evidence found, monument set, and accessories established at all corners set or maintained.

REGISTERED  
PROFESSIONAL  
LAND SURVEYOR

OREGON  
JULY 12, 1968  
DOUGLAS M. FERGUSON  
848

J-17 T5S R27E  
S10|S11  
S15|S14  
1992  
PLS 848  
Ponderosa Pine, 8" dia., bears N54°15'W, 26.5 ft., scribed: T5S R27E S10 BT  
Ponderosa Pine, 8" dia., bears N11°15'E, 43.7 ft., scribed: T5S R27E S11 BT  
Ponderosa Pine, 10" dia., bears S58°30'E, 14.9 ft., scribed: T5S R27E S14 BT  
Ponderosa Pine, 20" dia., bears S32°45'W, 123.1 ft., scribed: T5S R27E S25 BT

J-19 T5S R27E  
S11  
1/4 S14  
1992  
PLS 848  
White Fir, 12" dia., bears N28°37'W, 39.0 ft., scribed: 1/4 S11 BT  
White Fir, 10" dia., bears N25°13'E, 41.7 ft., scribed: 1/4 S11 BT  
Douglas Fir, 18" dia., bears S30°51'E, 19.6 ft., scribed: 1/4 S14 BT  
White Fir, 14" dia., bears S70°50'W, 20.3 ft., scribed: 1/4 S14 BT

J-21 T5S R27E  
S11|S12  
S14|S13  
1992  
PLS 848  
White Fir, 10" dia., bears N46°15'W, 19.8 ft., scribed: T5S R27E S11 BT  
Ponderosa Pine, 18" dia., bears N53°30'E, 49.9 ft., scribed: T5S R27E S12 BT  
Ponderosa Pine, 26" dia., bears S34°00'E, 36.9 ft., scribed: T5S R27E S13 BT

J-23 T5S R27E  
S12  
1/4 S13  
1992  
PLS 848  
Lodgepole Pine, 10" dia., bears N36°55'W, 140.9 ft., scribed: 1/4 S12 BT  
Ponderosa Pine, 28" dia., bears N00°32'W, 155.8 ft., scribed: 1/4 S12 BT  
Western Larch, 10" dia., bears S51°43'E, 38.4 ft., scribed: 1/4 S13 BT  
Western Larch, 12" dia., bears S64°37'W, 81.0 ft., scribed: 1/4 S13 BT

L-17 T5S R27E  
1/4  
S15|S14  
1992  
PLS 848  
Ponderosa Pine, 8" dia., bears N46°30'W, 27.0 ft., scribed: 1/4 S15 BT  
Ponderosa Pine, 8" dia., bears N09°30'E, 21.9 ft., scribed: 1/4 S14 BT  
Ponderosa Pine, 8" dia., bears S83°45'E, 32.2 ft., scribed: 1/4 S14 BT  
Ponderosa Pine, 22" dia., bears S10°15'W, 48.8 ft., scribed: 1/4 S15 BT

L-19 T5S R27E  
C 1/4  
S 14  
1992  
PLS 848  
Western Larch, 10" dia., bears N38°57'W, 70.1 ft., scribed: C1/4 S14 BT  
Douglas Fir, 12" dia., bears N33°53'E, 38.0 ft., scribed: C1/4 S14 BT  
Douglas Fir, 20" dia., bears S30°30'E, 89.5 ft., scribed: C1/4 S14 BT  
White Fir, 18" dia., bears S28°30'W, 81.8 ft., scribed: C1/4 S14 BT

L-21 T5S R27E  
1/4  
S14|S13  
1992  
PLS 848  
Douglas Fir, 26" dia., bears N49°36'W, 66.0 ft., scribed: 1/4 S14 BT  
White Fir, 14" dia., bears N74°13'E, 58.5 ft., scribed: 1/4 S13 BT  
White Fir, 24" dia., bears S62°09'E, 23.6 ft., scribed: 1/4 S13 BT  
White Fir, 16" dia., bears S00°48'W, 36.6 ft., scribed: 1/4 S14 BT

M-17 T5S R27E  
WC  
Line Tree  
S15 | S14  
1992  
PLS 848  
Western Larch, 14" dia., bears N21°30'E, 47.8 ft., scribed: LT S14 BT  
Ponderosa Pine, 12" dia., bears N74°45'W, 16.2 ft., scribed: LT S15 BT

N-17 T5S R27E  
S15|S14  
S22|S23  
1992  
PLS 848  
Douglas Fir, 26" dia., bears N84°15'W, 68.4 ft., scribed: T5S R27E S15 BT  
White Fir, 12" dia., bears S81°15'E, 70.5 ft., scribed: T5S R27E S23 BT  
Western Larch, 28" dia., bears S02°45'W, 56.8 ft., scribed: T5S R27E S22 BT

N-19 T5S R27E  
S14  
1/4 S23  
1992  
PLS 848  
Douglas Fir, 14" dia., bears N64°32'W, 16.1 ft., scribed: 1/4 S14 BT  
Douglas Fir, 10" dia., bears N58°16'E, 23.9 ft., scribed: 1/4 S14 BT  
Ponderosa Pine, 12" dia., bears S55°49'E, 41.7 ft., scribed: 1/4 S23 BT  
Douglas Fir, 16" dia., bears S18°22'W, 23.7 ft., scribed: 1/4 S23 BT

N-21 T5S R27E  
S14|S13  
S23|S24  
1992  
PLS 848  
Douglas Fir, 14" dia., bears N18°45'W, 36.1 ft., scribed: T5S R27E S14 BT  
Douglas Fir, 10" dia., bears N55°00'E, 21.3 ft., scribed: T5S R27E S13 BT  
White Fir, 10" dia., bears S89°30'E, 33.4 ft., scribed: T5S R27E S24 BT  
White Fir, 14" dia., bears S40°15'W, 36.3 ft., scribed: T5S R27E S23 BT

RECEIVED BY  
Morrow County Surveyor  
Date 7/9/92  
Rec'd By [Signature]  
No. C-937-E