

**NARRATIVE:**

The purpose of this survey is to stake the corners of that tract of land deeded to Edsel and Jennifer Wilson, recorded on M-18777, to see if the fence lines match the deed for a pending sale.

The survey & the bearings are based on Krumbein's 1985 survey for Morrow County in which he retraced Tamblin's 1935 survey of the Subdivision of Part of Section 24. Storms Replatted Block 7W of Tamblin's Plat in a 1948 survey. All monuments found conform to both Tamblin's Plat and Storms' Replat.


Storms took the South 30 feet of South Main, the West 10 feet of 1<sup>st</sup> Street and the East 10 feet of 2<sup>nd</sup> Street, as shown on Tamblin's map, and added them to Block 7 West.

The original division of Lot 6, described in Book 52, Page 496, gave some distances, more or less, to the centerline of an "irrigation ditch" which ran North and South. The West line of Wilson's parcel runs along the centerline of an irrigation ditch which was the original intent.


Wilson's deed and all preceding deeds of said Wilson tract does not except out Hensley's parcel as it should. Hensley's tract was first sold by Parker to Burkett on M-151 in 1967. Wilson's parcel was first sold by Parker to Jensen on M-2986 in 1970.

**LEGEND:**

- Found monuments, as noted.
- Set 1/2" x 24" rebar with plastic cap #951.
- (000) Krumbein's 1985 Survey for County, O-622-K.
- [000] Tamblin's 1935 Plat of Part of Section 24, Book 2, Page 5.
- <000> Storms' 1948 Replat of Blocks 7, 14 & 21 W of Tamblin's Plat, Book 2, Page 10.

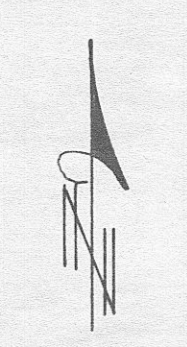

Scale: 1" = 100'

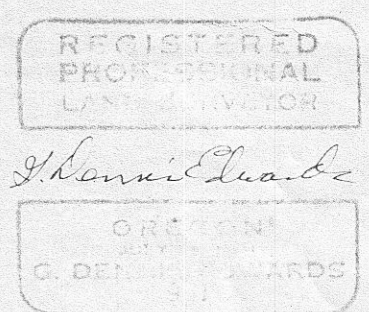

**RECEIVED BY**  
Morrow County Surveyor  
Date 3/93  
Rec'd By DE  
No. C-942-E (714)

Survey for **SHERMAN KIPLING**  
in Blk. 7W, in SE 1/4 Section 24, T5N, R26E, W. M.,  
Morrow County, Oregon  
11/2/92 Job #59210071  
Edwards Surveying P.O. Box 763  
567-3336 Hermiston, Oregon 97838