
ALTA/ACSM SURVEY FOR THE RESOLUTION TRUST CORPORATION

INSTITUTION NO. 7166
ASSET NAME: SANDPIPER APTS.
CONTRACT NO. 0731-92-0978-001

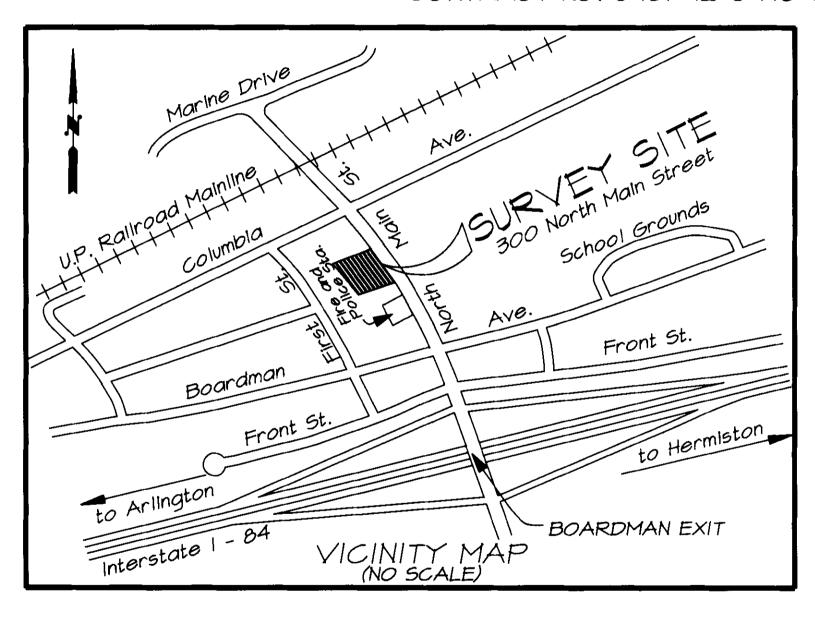

INDEX TO PLAT SHEETS:

SHEET I: (this sheet), VICINITY MAP AND NOTES.
SHEET 2: SITE BOUNDARY.

SHEET 3: DETAIL OF SITE.

ZONING DESIGNATION OF SITE:

R-2, MULTI-FAMILY RESIDENTIAL.

BUILDING SETBACKS:

AS INTERPRETED FROM CITY OF BOARDMAN ZONING ORDINANCE NO. 159, SECTION 3.023, BY CITY MANAGER'S OFFICE:

FRONT: 20 FEET.

SIDES: 10 FEET.

REAR: 25 FEET.

SETBACKS ARE SHOWN ON SHEET 3 OF 3.

FLOOD ZONE DESIGNATION:

BASED ON FIA FLOOD HAZARD BOUNDARY MAP FURNISHED BY THE CITY OF BOARDMAN, THE SURVEY SITE IS NOT CLASSIFIED AS A SPECIAL FLOOD HAZARD AREA.

REFERENCE: DEPT. OF HOUSING AND URBAN DEVELOPMENT, FEDERAL INSURANCE ADMINISTRATION, CITY OF BOARDMAN, OR. FIA FLOOD HAZARD BOUNDARY MAP NO. H OI. EFFECTIVE DATE: DECEMBER 13, 1974.

RECEIVED BY

Morrow County Surveyor

Date 10/93

Rec'd By 5KB

B-966-E (738

REGISTERED PROFESSIONAL LAND SURVEYOR

Will. R. Wells

OREGON
JULY 22, 1977
WILLIAM R. WELLS
1106

WILLIAM R. WELLS, PLS 357 N.E. HWY. II P.O. BOX 1696

PENDLETON, ORE. 97801 PHONE: (503) 276-6362

DATE: 2/07/43 DR. BY: MEQ CK. BY: MRM NO: 42-157

SHEET | OF 3 VACADIZVETCPI

PROJECT:
ALTA/ACSM SURVEY FOR
RESOLUTION TRUST CORPORATION
INSTITUTION NO. 7166
ASSET NAME: SANDPIPER APTS,
CONTRACT NO. 0731-92-0918-0001
LOTS 4,5 4 6, REPLAT OF LOTS 1
4 2, BLOCK 2, NORTH BOARDMAN
ADDITION, LOCATED IN THE SM V4
OF SEC. 9, 74N, R29E, MM,
MORROW COUNTY, ORESON

