


BLOCKS 1 & 2
AYERS 4' ADDITION TO HEPNER

Scale, 1 inch = 50.0 ft.

Jan. 29 1917

By M. Turner.

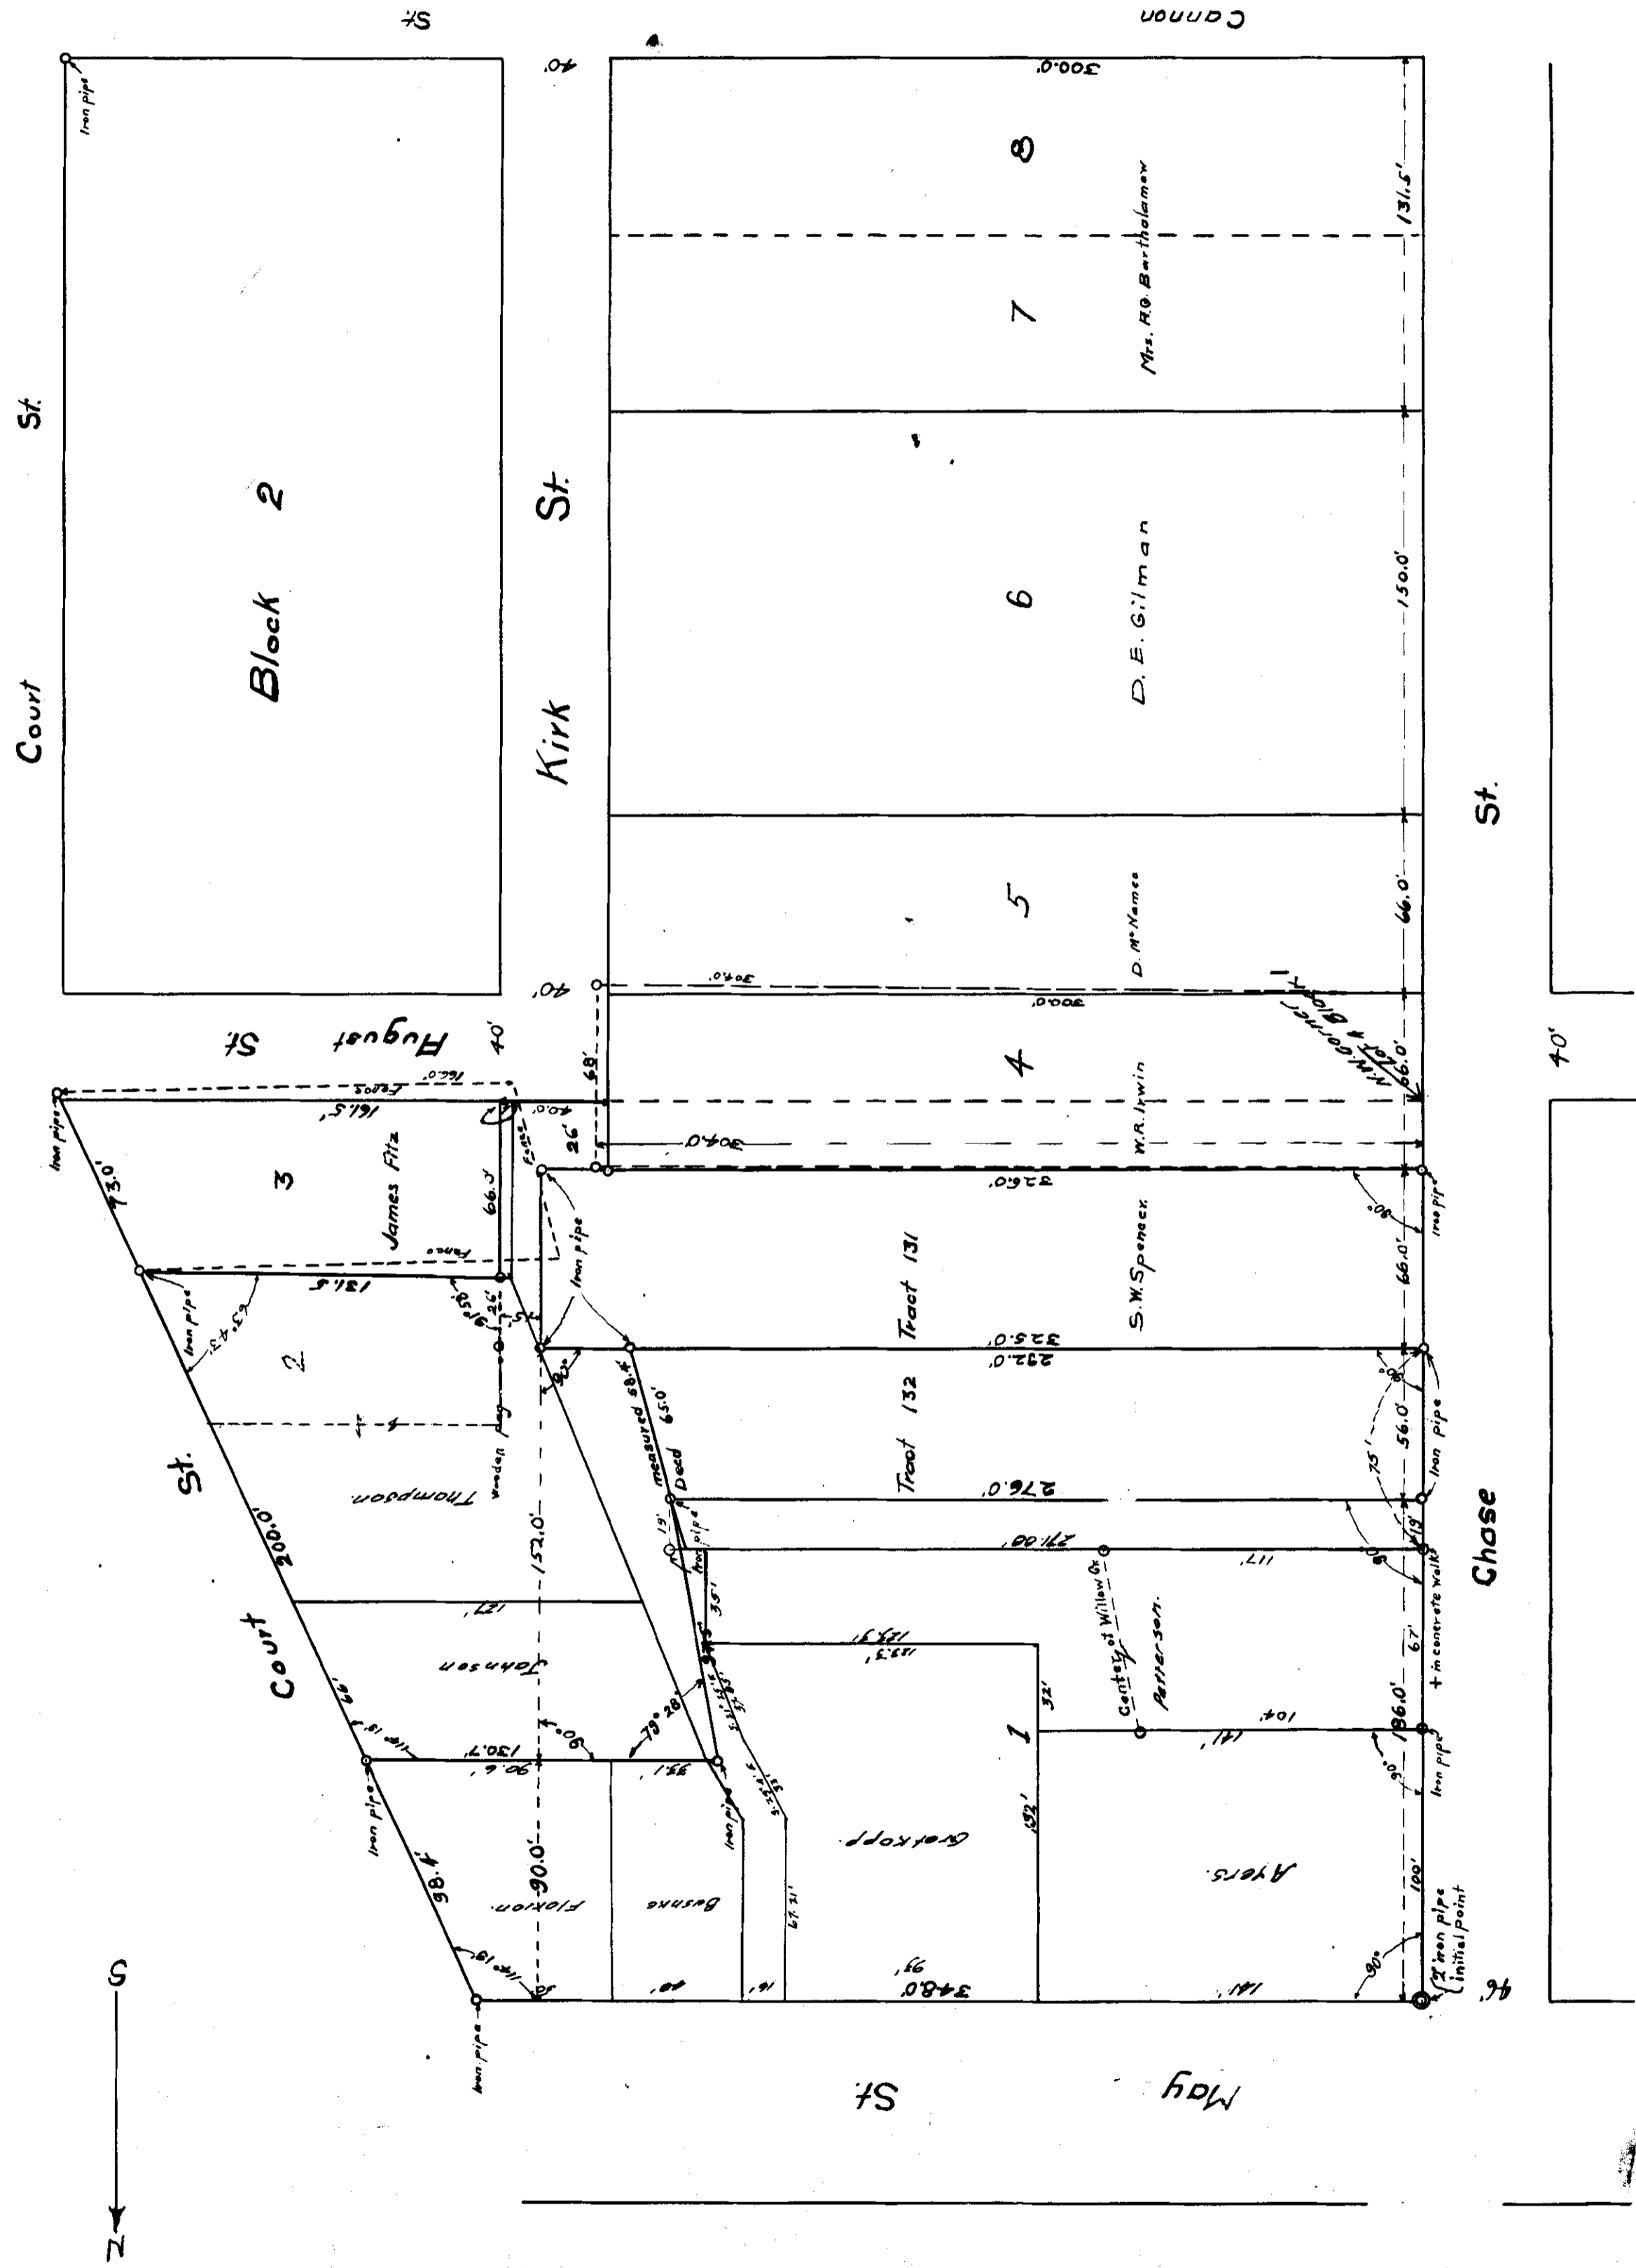

RECEIVED BY
 Morrow County Surveyor
 Date 1/7/1917
 Rec'd By S.M.B.
 No. C-943-E-753