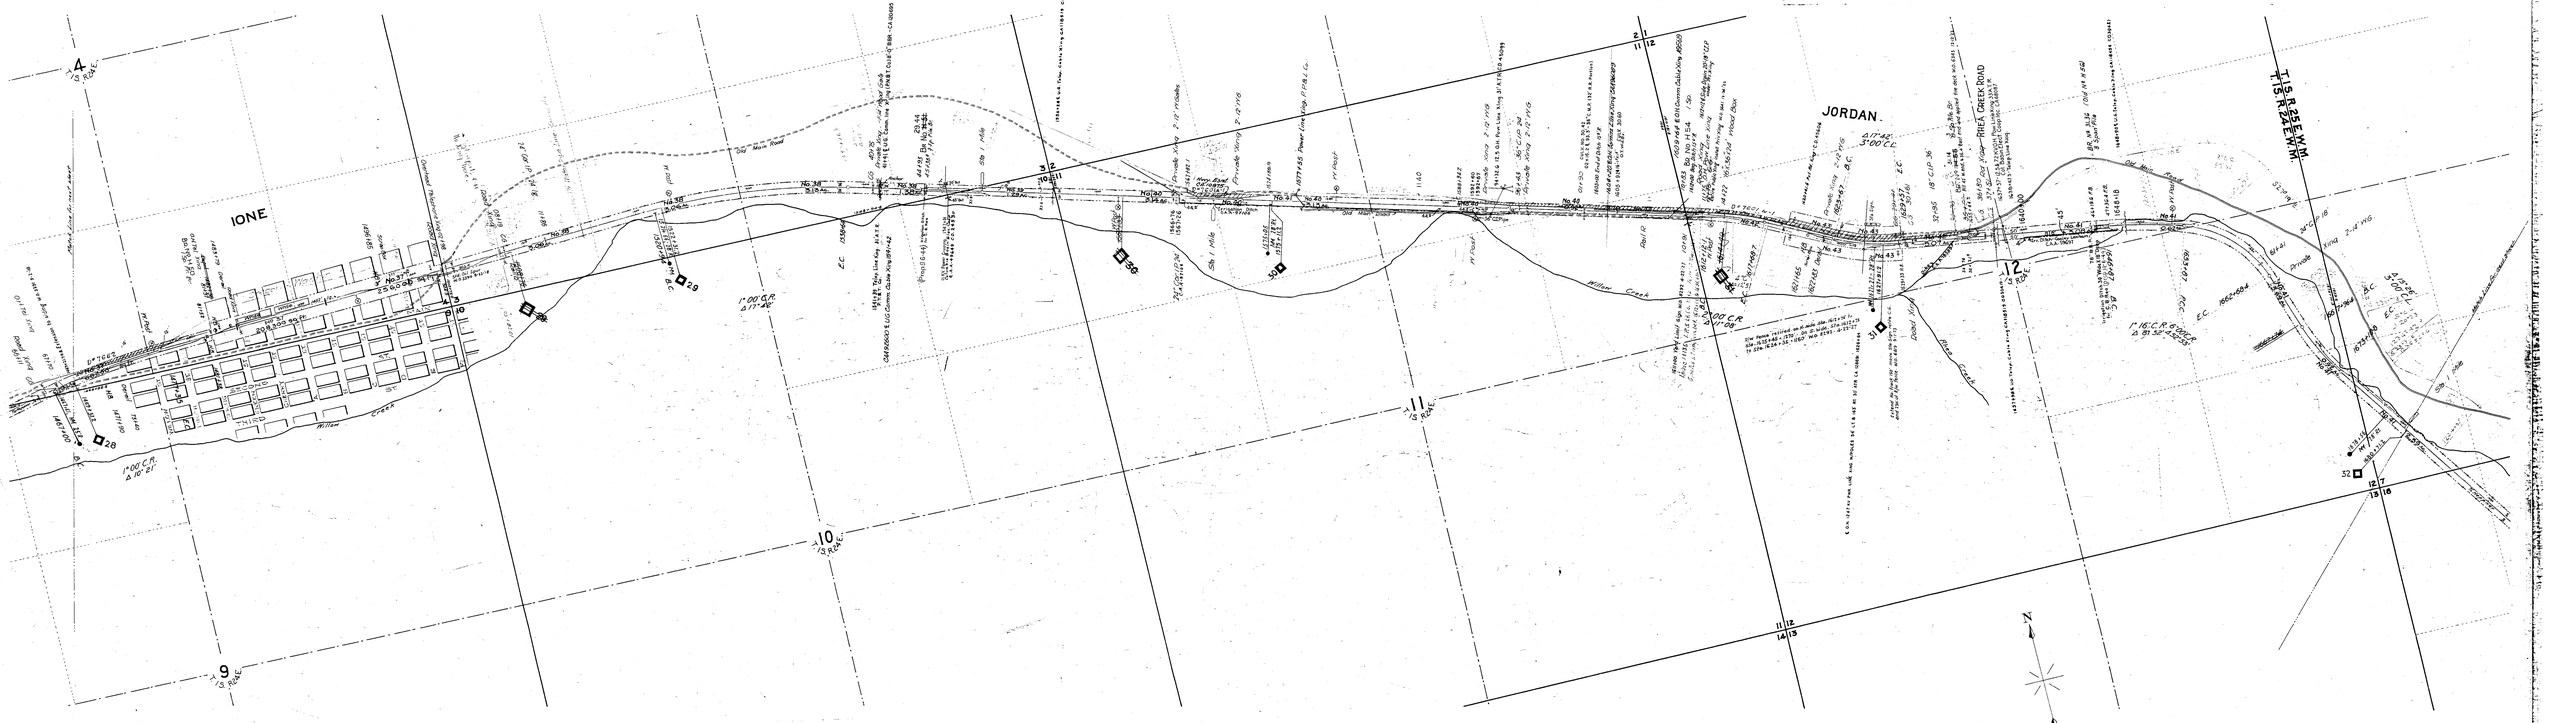
IONE
JORDAN
T.1 S. R.25 E.W.M.
T.1 S. R.24 E.W.M.
A
9
10
11
12
13 R.24 E.
13 R.25 E.
Willow Creek
Rhea Creek
Old Main Road
Main Road
Private Road
Sta. 1 Mile
