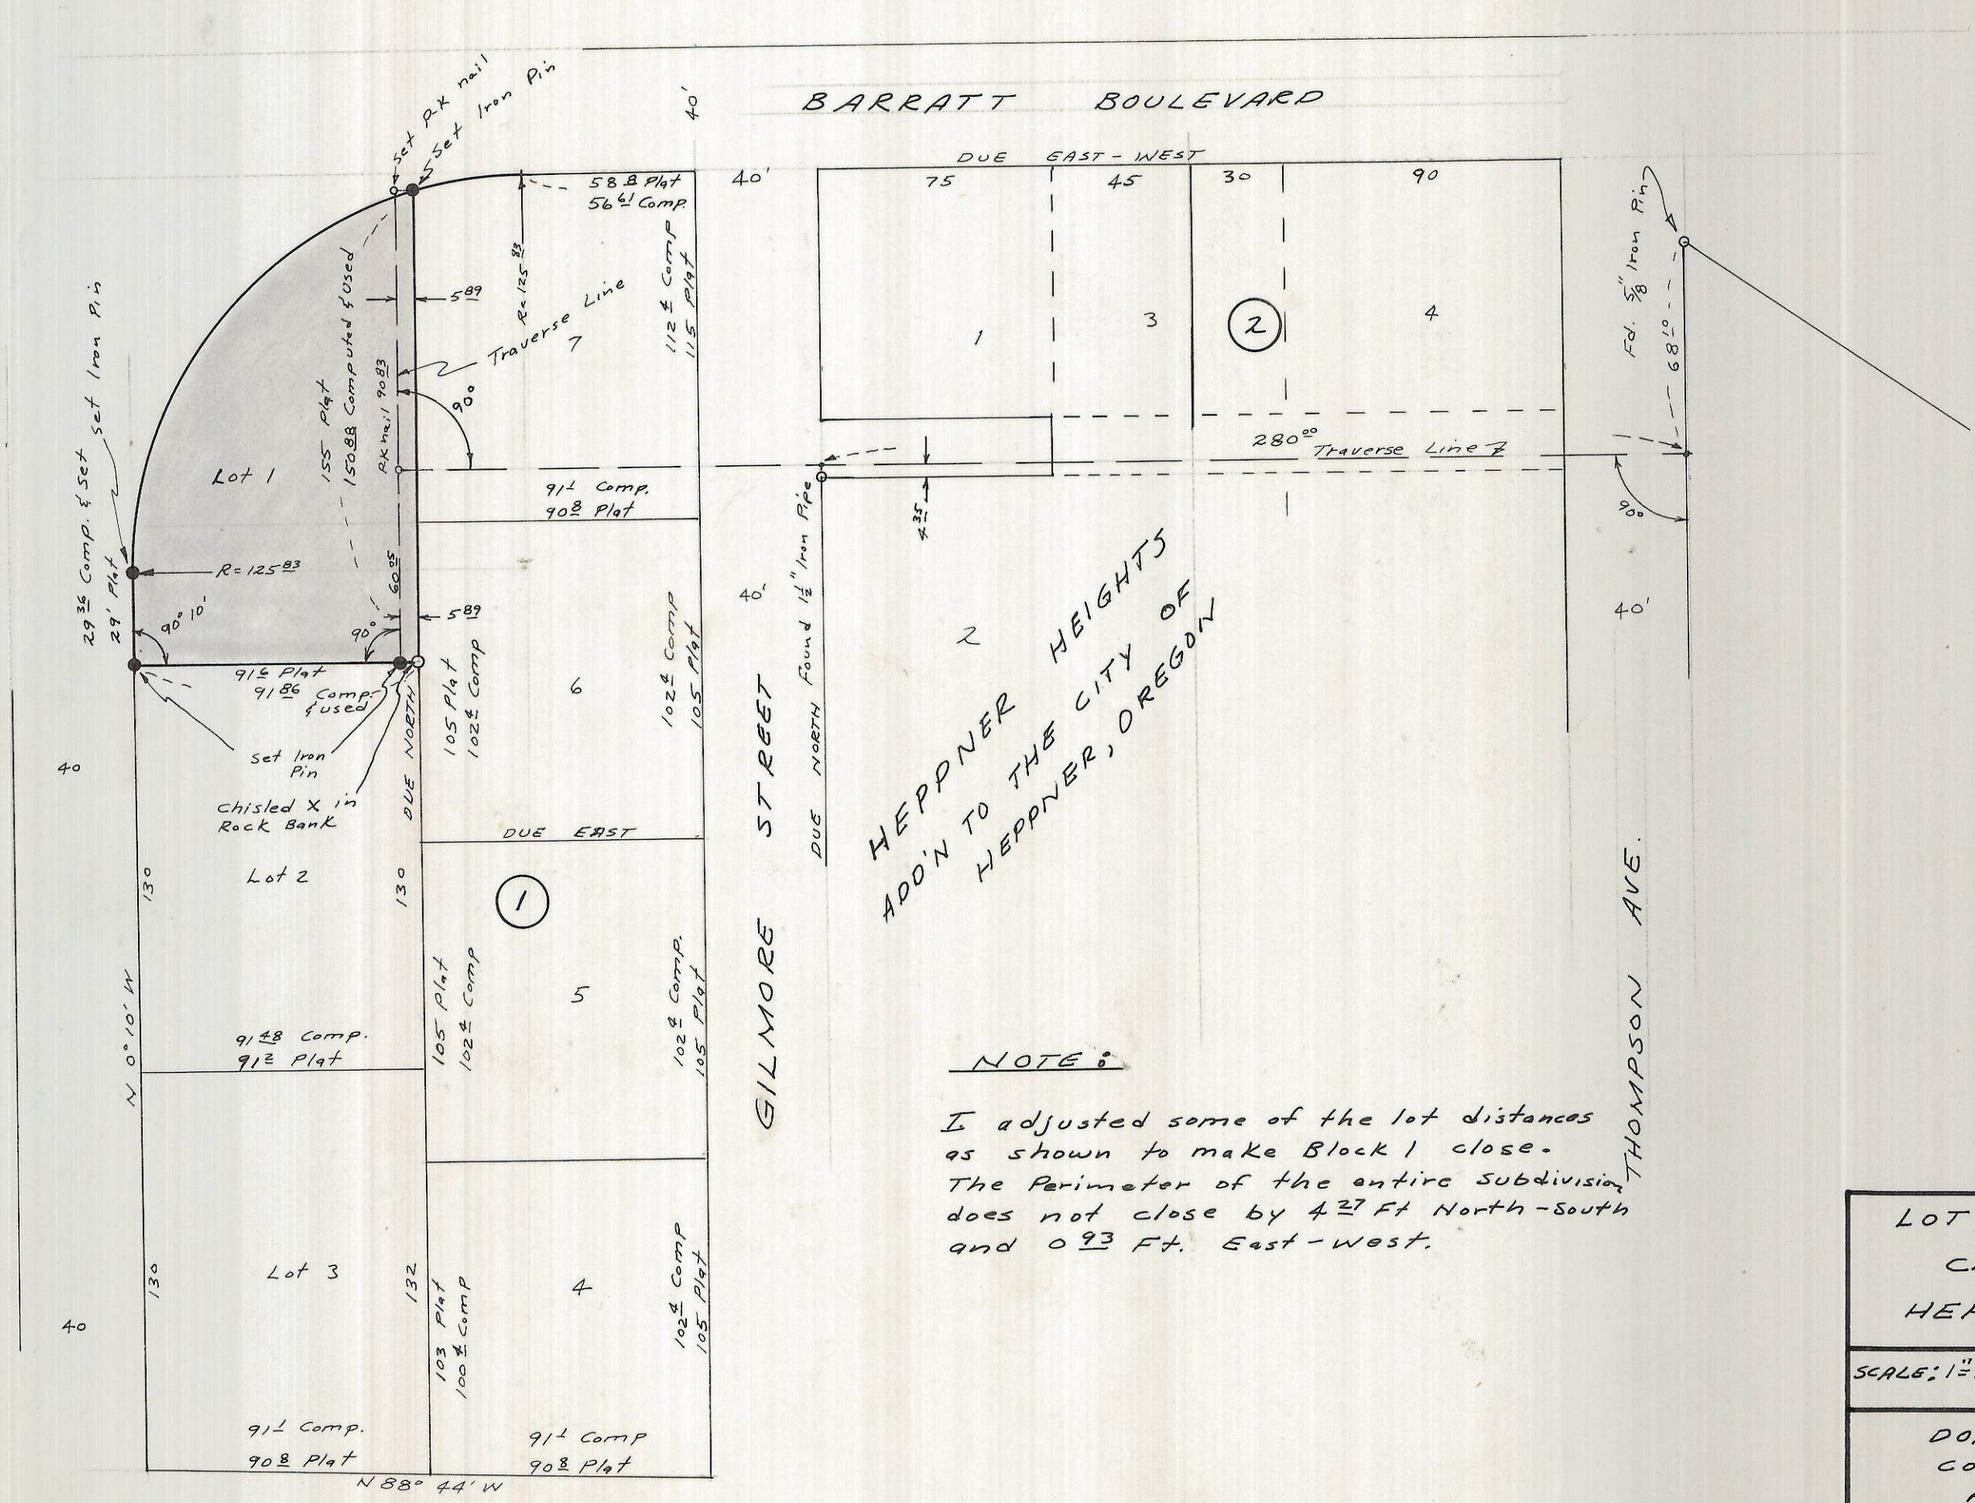


NOTE:

I adjusted some of the lot distances as shown to make Block 1 close. The Perimeter of the entire subdivision does not close by 4.27 Ft North-South and 0.93 Ft. East-west.

REGISTERED PROFESSIONAL ENGINEER 5406 OREGON JULY 9, 1965 DONALD L. STAEBLER

Donald L Staebler

LOT SURVEY FOR
CLISTA VENARD
HEPPNER, OREGON

| SCALE: 1"=50' | AUG 18, 1971 | |
|---|---|---|


DONALD L STAEBLER
CONSULTING ENGINEER
P.O. Box 91
PENDLETON OREGON


B 1005 E 777