

SURVEY for

Leland O. McKinney
P.O. Box 2032
Lake Havasuc, AZ. 86403

C/O
Allen & Connie Gordanier
P.O. Box 290
Irrigon, Oregon 97844

Part of Lot 2, Block 4W
City of Irrigon, Oregon
T. 5N., R. 26E., W.M., Section 25
Southwest 1/4 of the Northeast 1/4


Found 2 1/2"
Brass Cap
PLS #933

LEGEND


- SET MONUMENTS - 5/8" x 30" Iron Rods
W/ Plastic Caps Stamped - L.S. # 2431
- FOUND MONUMENTS - 5/8" Iron Pins W/
Plastic Caps PLS 872 - Or As Noted
- ⊙ FOUND SECTION MONUMENTS - As Noted
- ⊙ CALCULATED POINTS - Not Set
(form Krumbein Survey #D-865-K)
- STREET or BLOCK LINES
- (000) RECORD BEARINGS & DISTANCES (D-865-K)
- [000] TAMBLYN'S 1935 PLAT of SEC. 25

NARRATIVE:

The purpose of this survey was for the location of property lines so that the owners could construct fence lines and make improvements to the property. This survey is based on a resurvey of Tamblyn's Subdivision Plat by Krumbein (C.S. #D-865-K). The basis of bearing was the centerline of the County Road on the south side of Block 4W. Using the found monuments from Krumbein's survey, I proportioned the distances to establish the Lot Lines within the Block. I established the corners of both Lot 1 and Lot 2, of which, Lot 1 had been previously partitioned by Tuttle. I then separated the adjacent Lot to the South, which is described as the South 140.00 feet of the Original Lot 2. The parcel remaining is the deeded lot for McKinney C/O the Gordaniers.

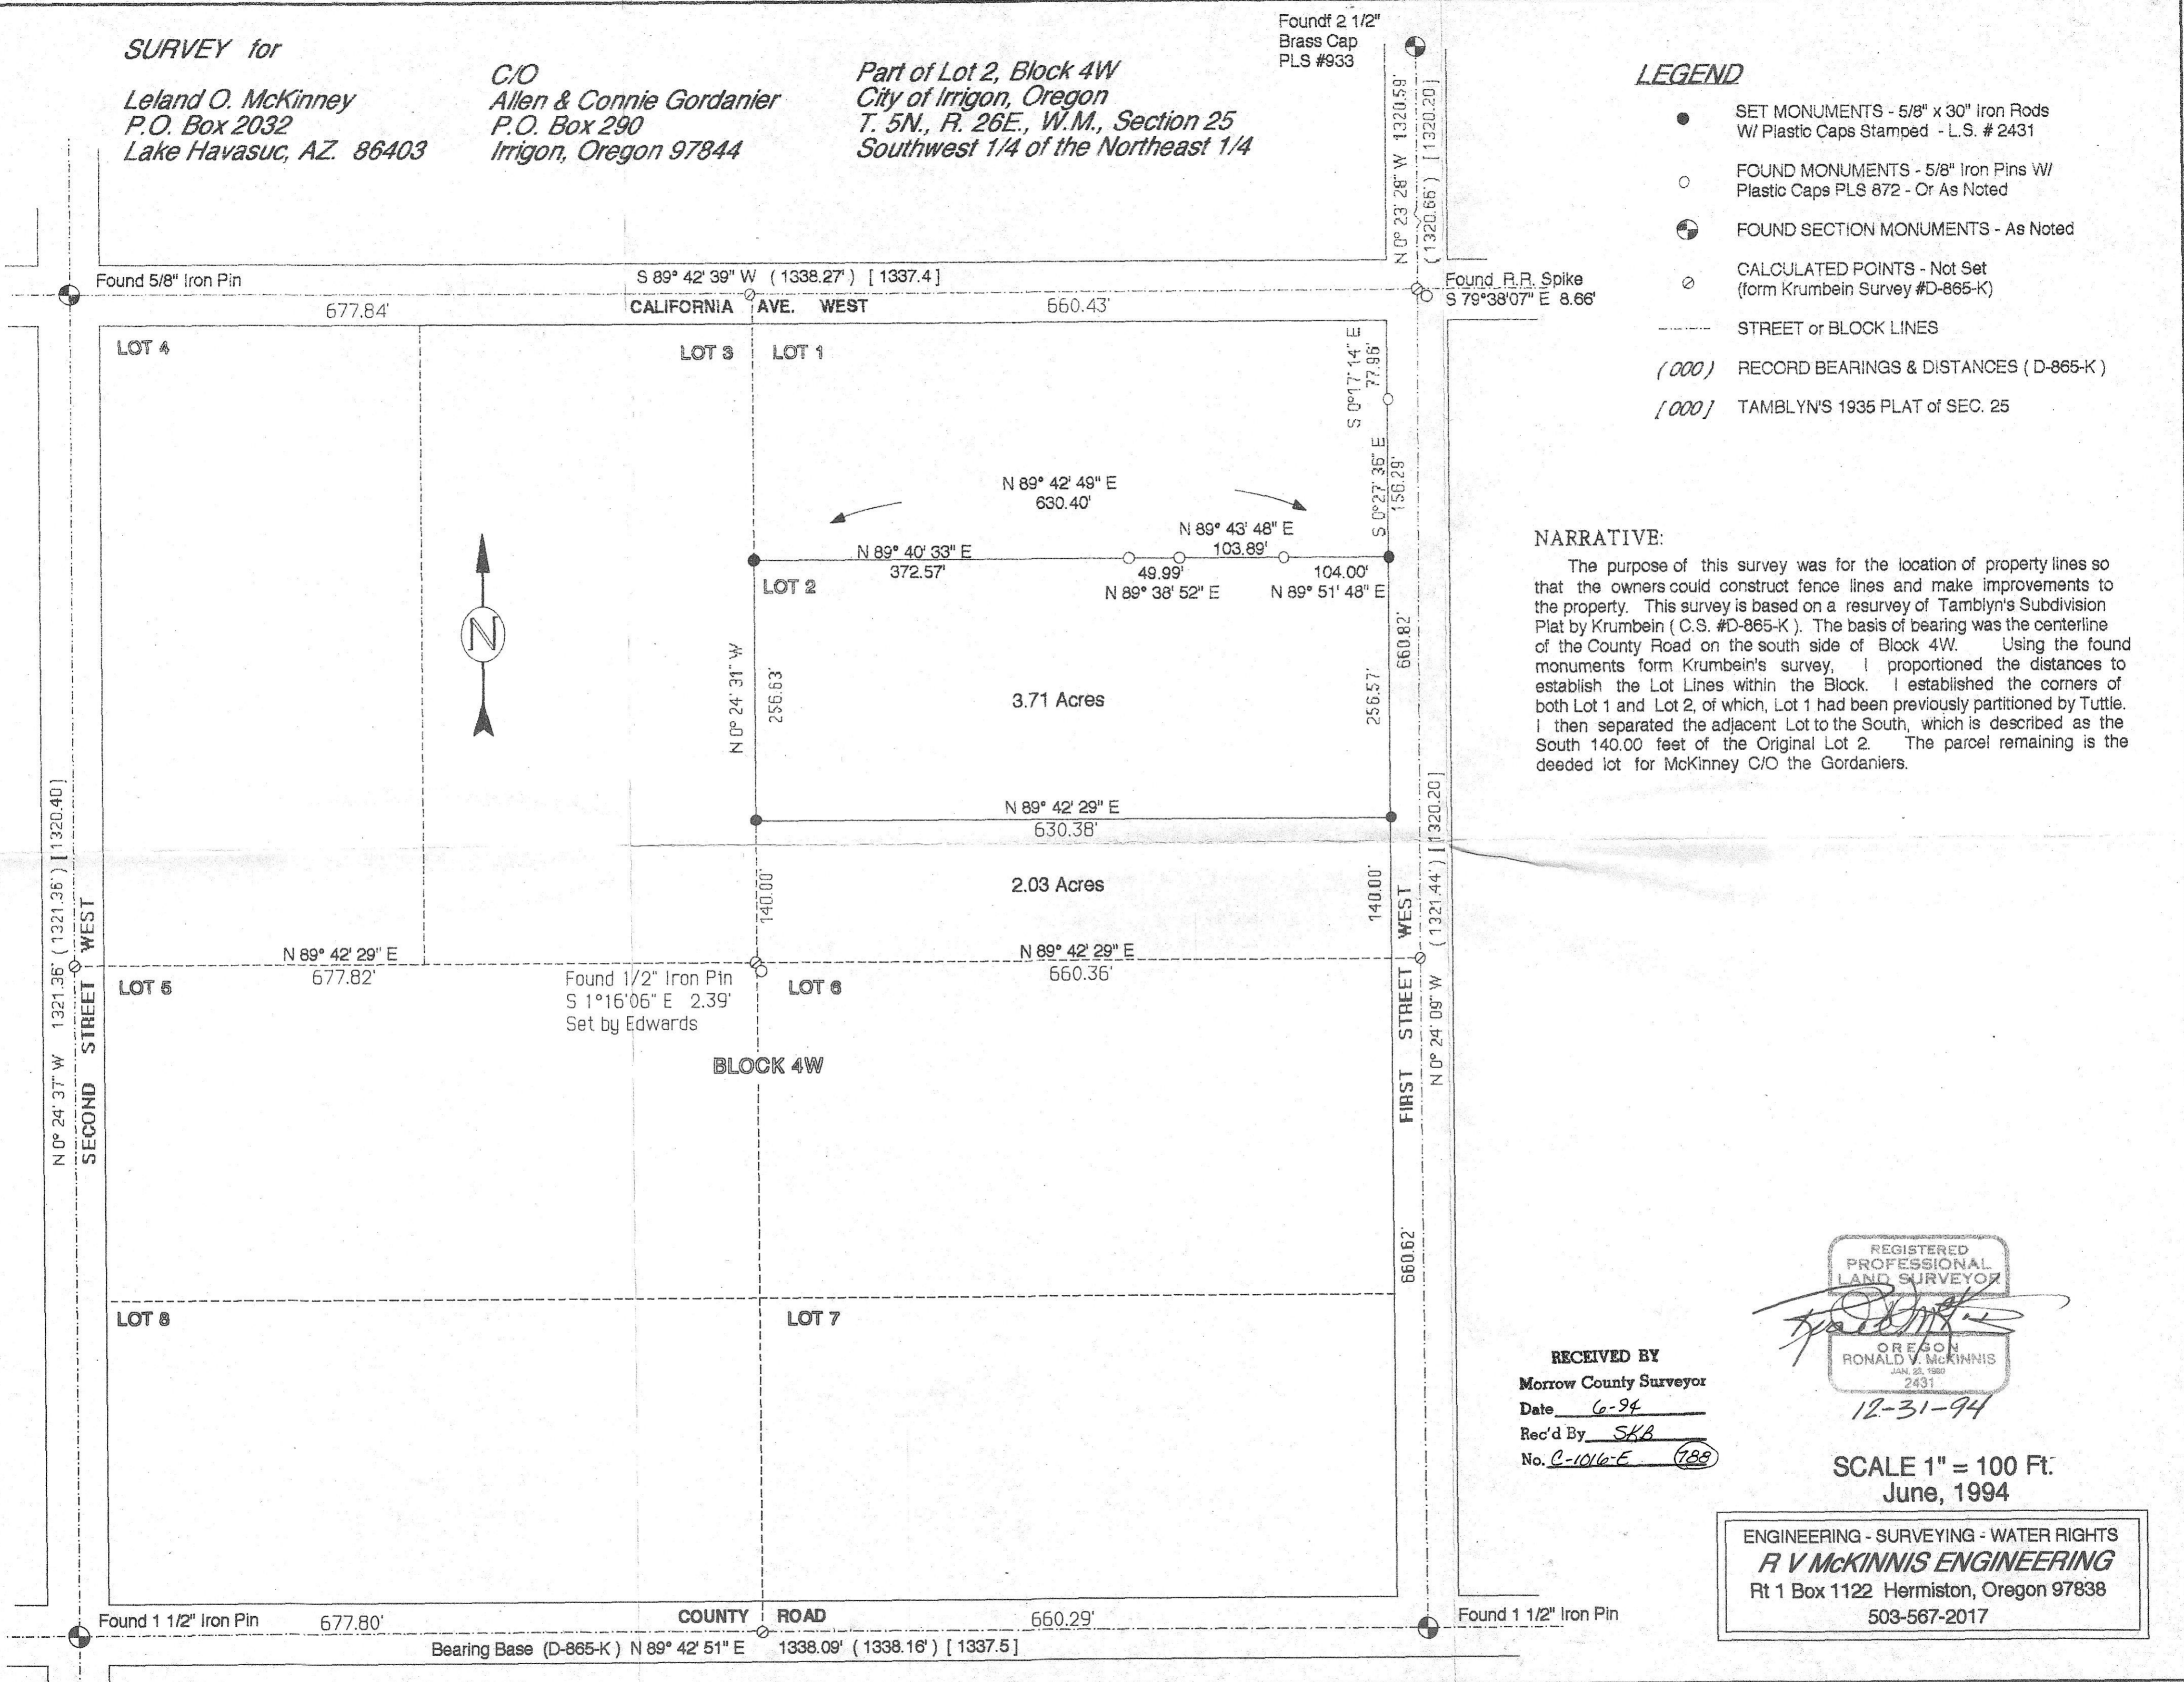

RECEIVED BY
Morrow County Surveyor
Date 6-94
Rec'd By SKB
No. C-1016-E (188)

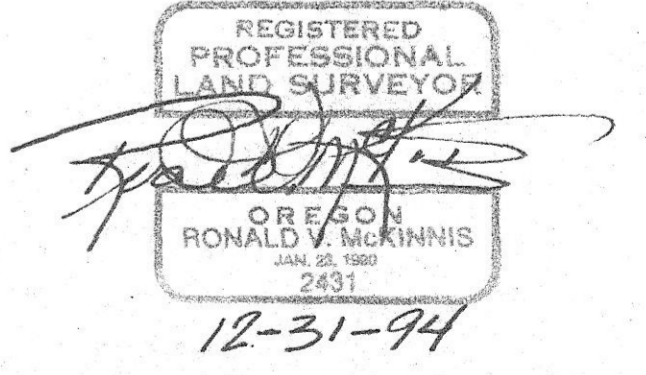

SCALE 1" = 100 Ft.
June, 1994

ENGINEERING - SURVEYING - WATER RIGHTS
R V MCKINNIS ENGINEERING
Rt 1 Box 1122 Hermiston, Oregon 97838
503-567-2017