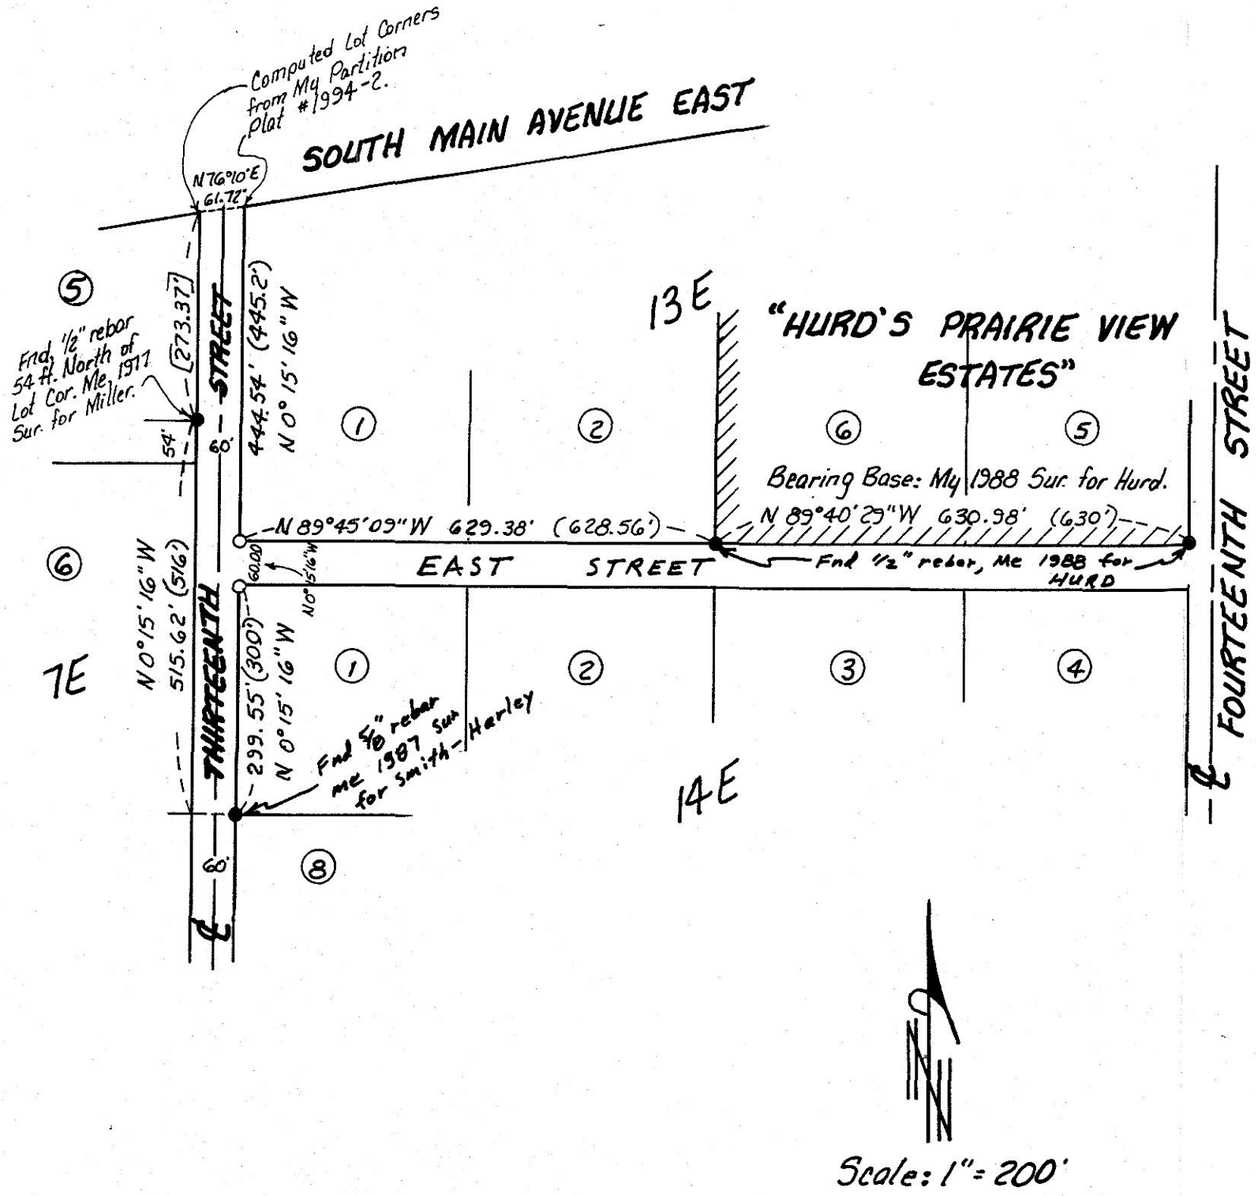

Scale: 1" = 200'

NARRATIVE:

The purpose of this survey is to stake East Street so it can be built on the right of way.

REGISTERED PROFESSIONAL LAND SURVEYOR

G. Dennis Edwards

OREGON
JULY 16, 1971
G. DENNIS EDWARDS
951

LEGEND:

- ● Found monuments, as noted.
- ○ Set 5/8" x 30" rebar with plastic cap #951.
- (000) of Record. Tamblyn's 1935 Plat of Section 19.
- [000] of Record. My Partition Plat #1994-2.

RECEIVED BY
Morrow County Surveyor
Date 8/24/94
Rec'd By SKB
No. B-1025-E (798)

Survey for the CITY OF IRRIGON
In Block 13E, SE 1/4 Section 19, T5N, R27E, W.M.,
Morrow County, Oregon
8/17/94 Job #S9408092

Edwards Surveying P.O. Box 763
503-567-3336 Hermiston, Oregon 97838