

# NARRATIVE

The purpose of this survey is to stake the Northeast corner of Block 43 which is on the West R/W line of 11<sup>th</sup> Street.

There were many deeds which included a 100 foot strip, 30 to 40 feet wide, of 11<sup>th</sup> Street with Lots 1 and 2 of said Block 43. Those deeds are recorded on M-7512, M-7513, M-10430, M-10431. A later deed M-29571 and the last one to Burns M-41994 except "the East 30 feet of the North 100 feet" lying within 11<sup>th</sup> Street.



About 5 feet of a house lies within 11<sup>th</sup> Street right of way.

The monuments I used check within 2 inches in over a quarter of a mile of the original plat of the "Town of Irrigon." There is a Bolt in a concrete monument about 6 feet West of the Northwest corner of Lot 2. The deeds do not refer to Lot corners.

REGISTERED  
PROFESSIONAL  
LAND SURVEYOR

*G. Dennis Edwards*

OREGON  
JULY 18, 1971  
G. DENNIS EDWARDS  
351

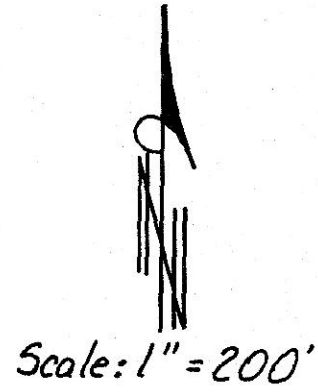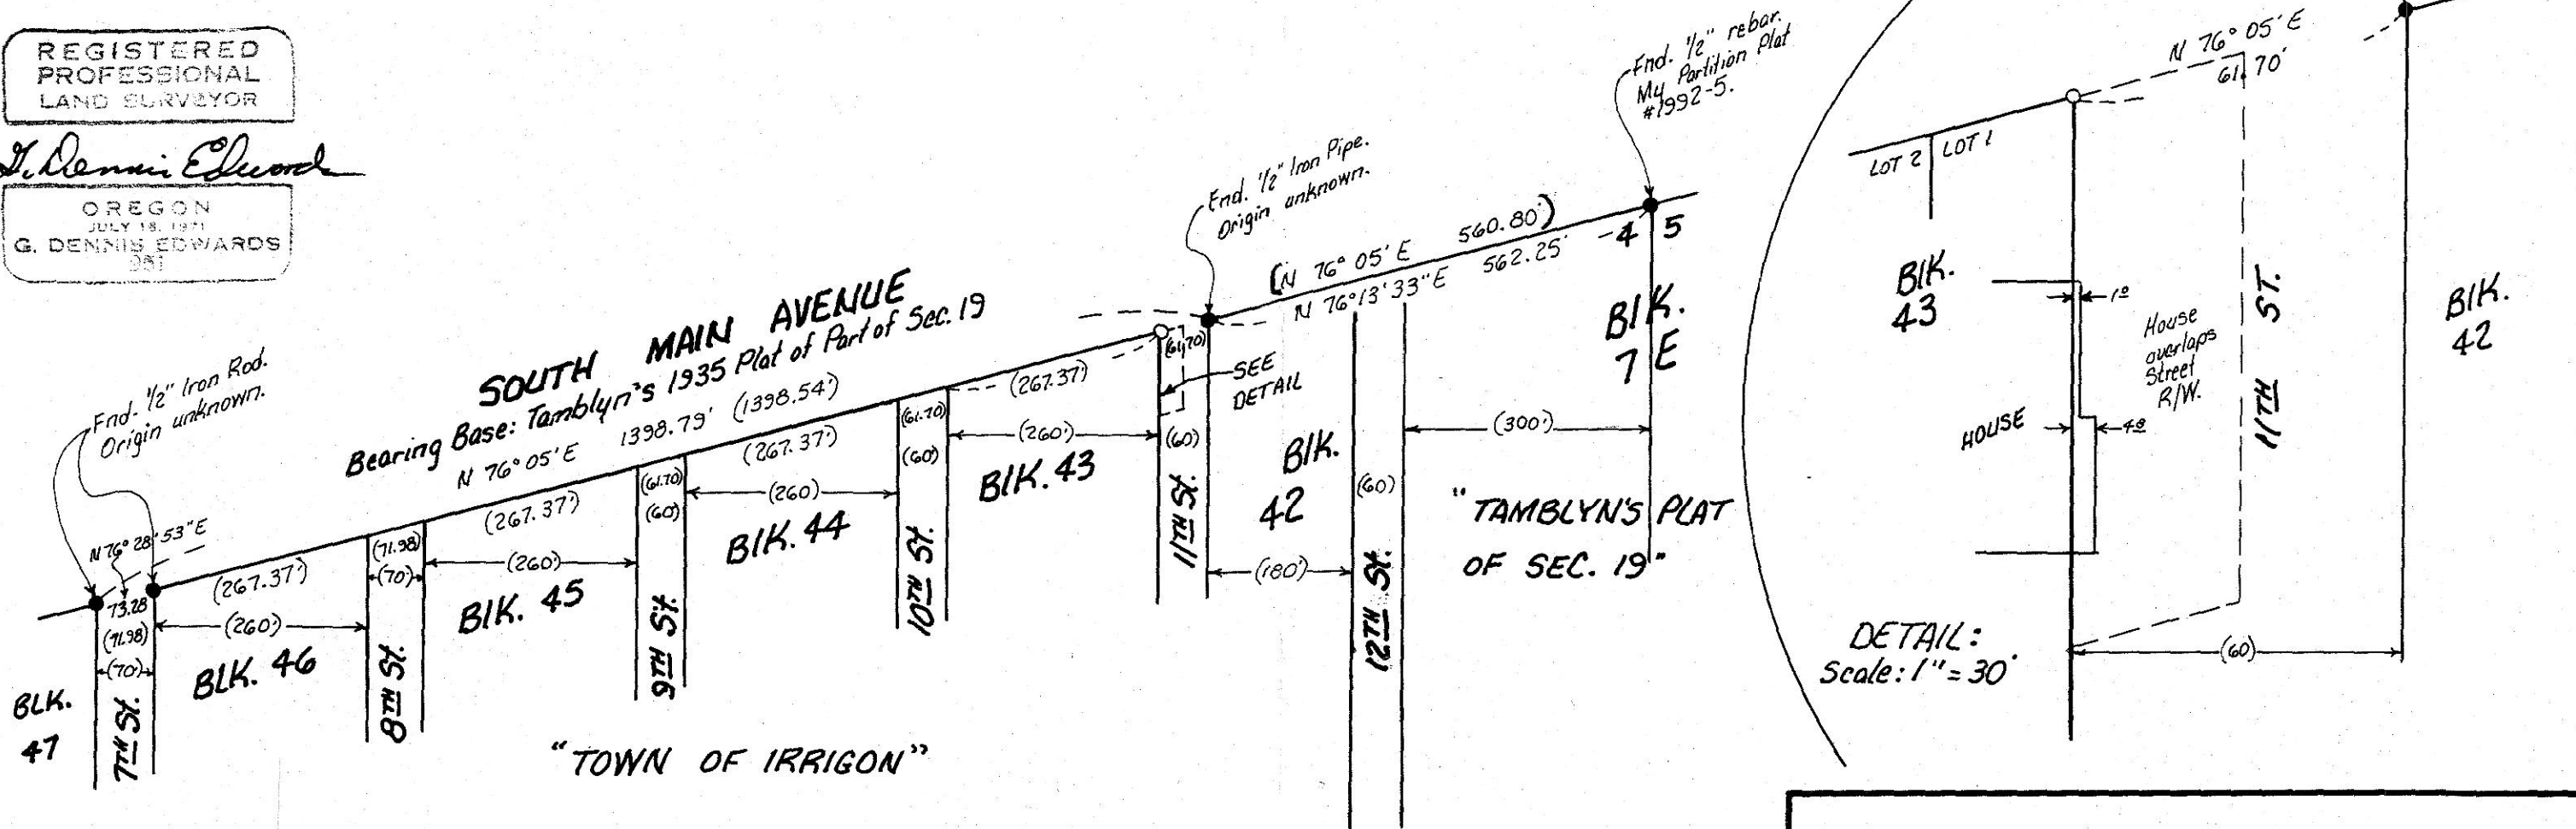

# LEGEND:

- Found monuments, as noted.
- Set 5/8" x 30" rebar with plastic cap #951.
- (ooo) of Record. Tamblin's 1935 Plat of the Subdivision of Part of Section 19. & THE PLAT of "TOWN OF IRRIGON"

RECEIVED BY  
Morrow County Surveyor  
Date 8/24/94  
Rec'd By SKB  
No. B-1026-E (799)

Survey for the CITY OF IRRIGON  
In Block 43, "TOWN OF IRRIGON"  
In SW 1/4 Section 19, T5N, R27E, W.M.,  
Morrow County, Oregon  
8/18/94 Job #59408093  
Edwards Surveying P.O. Box 763  
503-567-3336 Hermiston, Oregon 97838