

321.59  
ACRES

Scale: 1" = 400'

DETAIL:  
Scale: 1" = 200'


**NARRATIVE:**

The purpose of this survey is to do a boundary line adjustment of three parcels which make up the North Half of Section 4, except the 5 acre parcel in the Northeast corner. The acreages before were 281.41 with a mobile home, 36.00 with the North house and shop and 1.15 with the South house. The resulting acres are 321.59 acres with the mobile home, 1.00 acre with the North house and 1.26 acres with the South house and shop. The resulting acreage is about 5 acres more than the acreage shown on the tax maps but is by actual survey. The bearings and survey are based on monuments found from Gould's 1940 G.L.O. dependent resurvey.

The East line of Section 4 is the boundary line of Morrow and Umatilla Counties and there is a public road running along it. I could not get any documentation as to its width or location from the public works departments of either county. At this location there is an approximately 30 foot gravelled surface which lies completely in Umatilla County and Umatilla County maintains it.

**LEGEND:**

- Found 2 1/2" Brass Cap set by Gould in 1940 G.L.O. Dependent Resurvey, unless noted otherwise.
- Set 5/8" x 30" rebar with plastic cap #951.
- (ooo) of Record. Gould's 1940 G.L.O. Dependent Resurvey.

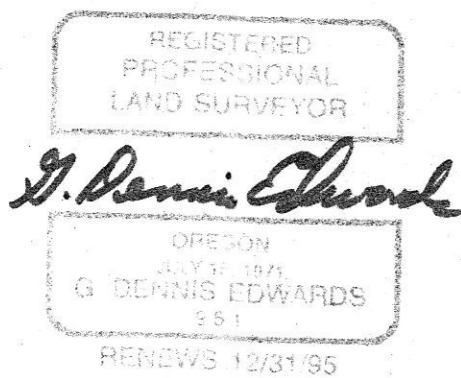

RECEIVED BY  
Morrow County Survey  
DATE 1/25/96  
RECD BY SKB  
No C-1070-E (843)

Survey for DON KEY  
In the NE 1/4 of Section 4, T3N, R27E, W.M.,  
Morrow County, Oregon  
12/21/95 Job #59512203  
Edwards Surveying P.O. Box 763  
541-567-3336 Hermiston, Oregon 97838

Replaced bent Gould  
Mon. with 1" x 30"  
Iron Pipe with 2 3/8"  
Brass Cap.