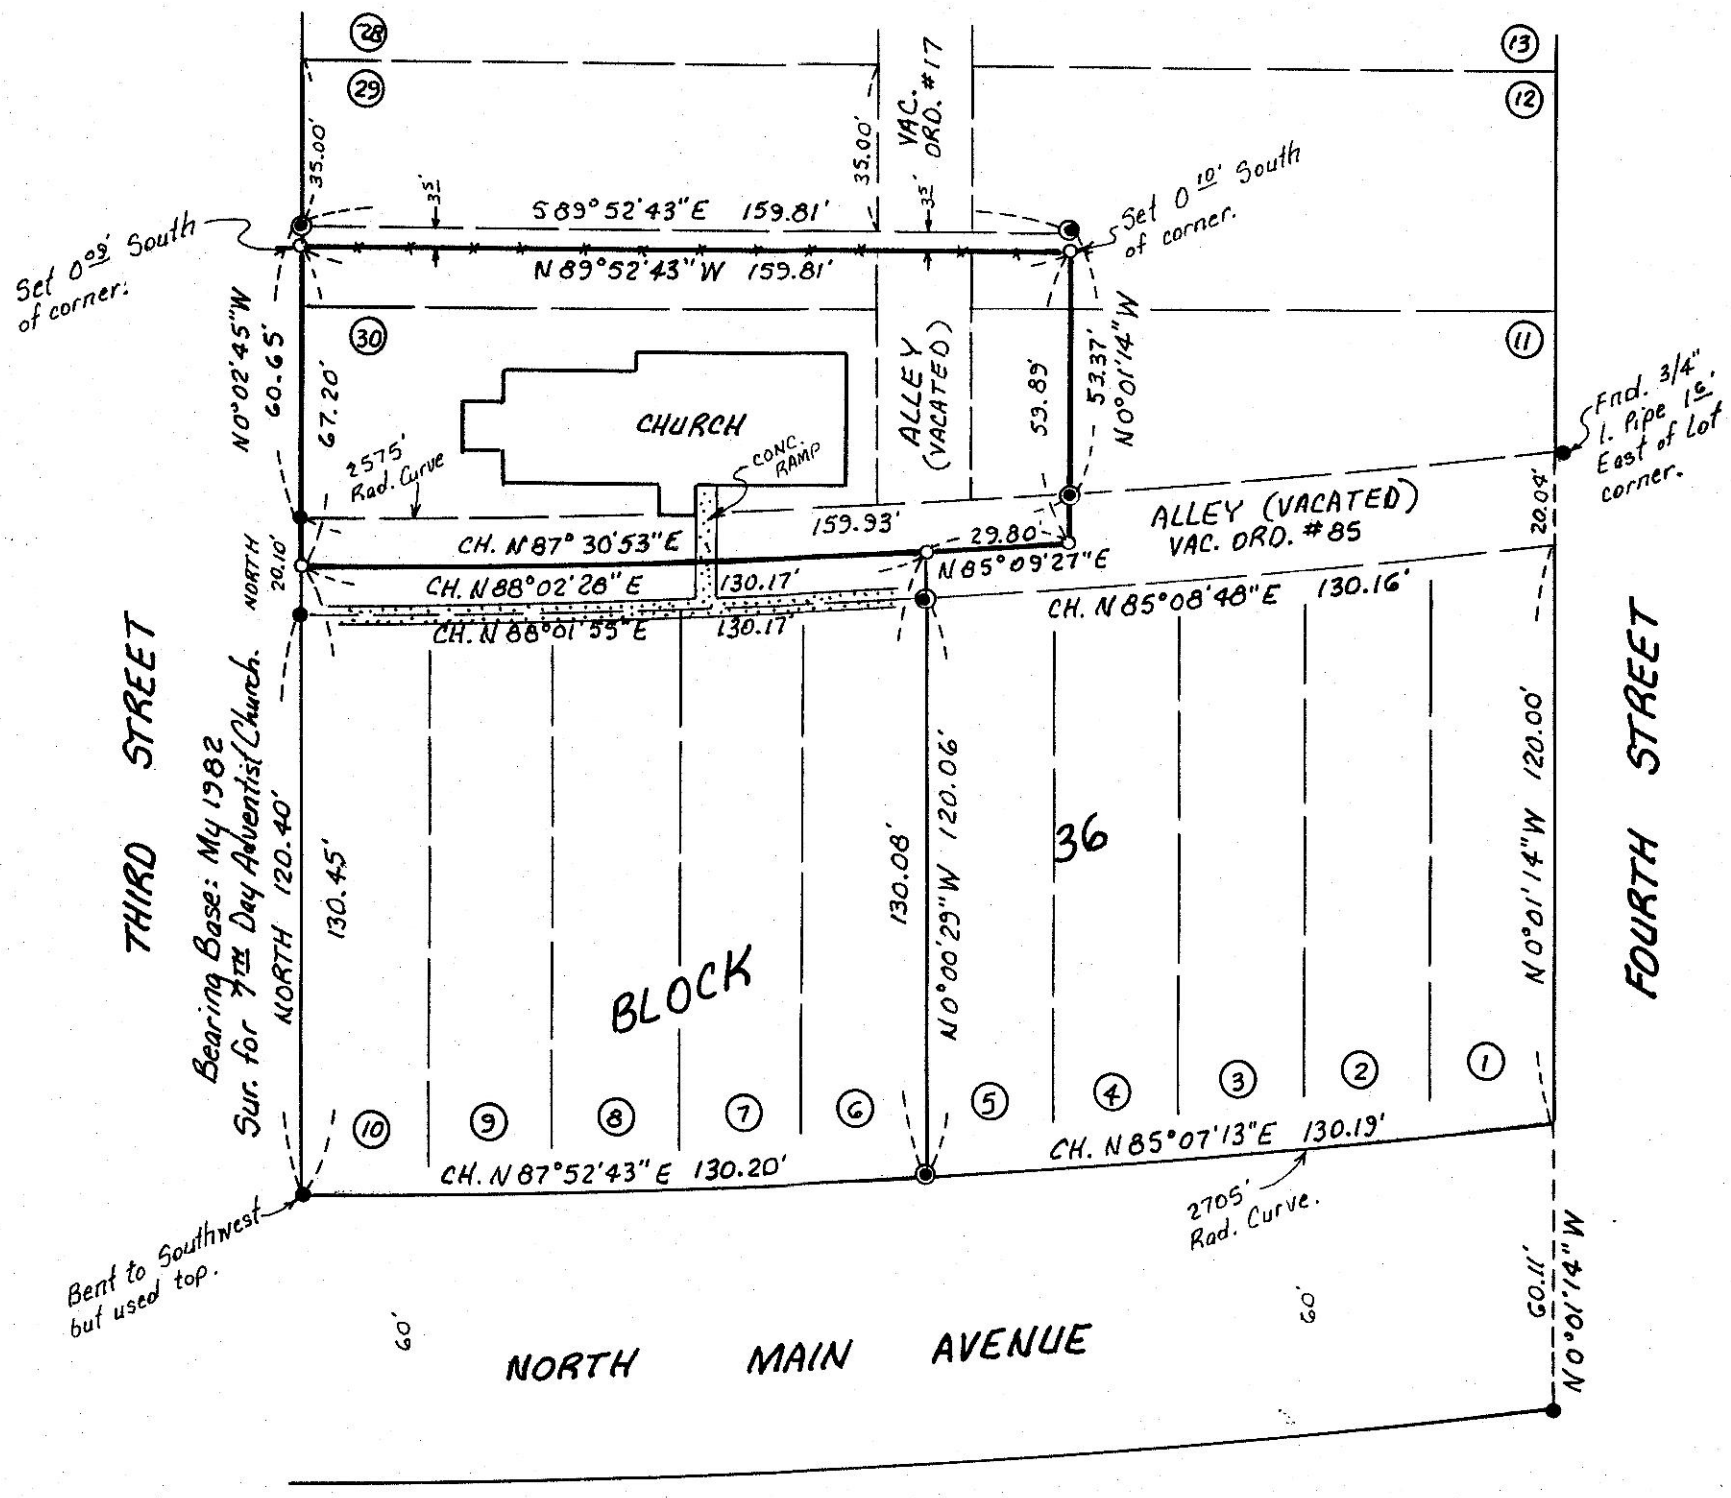

NARRATIVE:

The purpose of this survey is to stake the new property corners of the property I surveyed for the Seventh-Day Adventist Church in 1982. The changes include portions of the East-West vacated alley and exclude the 3.5 foot strip deeded to Maxine Henry in a Quit Claim Deed of April 28, 1982. I found all of my 1982 monuments and based this survey and the bearings on that 1982 survey. The South corners of Henry's parcel had to be set South of their true location because they fell in a concrete curb.

Scale: 1" = 40'

0 20 40 80

LEGEND:

- ● Found 1/2" rebar. Origin unknown.
- ◉ Found 1/2" rebar, set by Me in 1982 Survey for the 7th Day Adventist Church.
- ○ Set 5/8" x 30" rebar with plastic cap #951.

REGISTERED PROFESSIONAL LAND SURVEYOR

G. Dennis Edwards

OREGON JULY 16, 1971 G. DENNIS EDWARDS 951

RENEWS 12/31/97

RECEIVED BY
Morrow County Surveyor
Date 2/28/96
Rec'd By SKB
No. B-1075-E 848

Survey for SEVENTH-DAY ADVENTIST CHURCH
In Block 36, City of Irrigon
In SE 1/4 Section 24, T5N, R26E, W.M.
Morrow County, Oregon
1/30/96 Job #S8202004-A
Edwards Surveying P.O. Box 763
541-567-3336 Hermiston, Oregon 97838