


**NARRATIVE:**

The purpose of this survey is to stake that tract of land decided to Paul Lang on M-46473, Morrow County Deed Records, so setbacks can be determined for an addition to an existing house.

Lang's Northeast corner is supposed to be 232 feet South and 416 feet West of the NE Cor of Sec. 34 but I established it at 231.68 feet South of the North line of Section 34 which is the proportional distance between the North line of the Section and the North line of Center Street which I assumed to be the North edge of a concrete sidewalk. I used the East edge of a concrete retaining wall for the easting location of Lang's Northeast corner because it is the apparent property corner and is confirmed by the fence line on the property line to the North which is a projection of Lang's East line. I then made Lang's East and West lines parallel with the East line of Section 34 and made his North and South lines run on the average bearing of Center Street and the North line of Section 34.

There is no record of the 1/2" iron pipe I found near the Southwest corner of Reid's property and it is over 6 feet from the deed location so I did not use it to establish Lang's corners.

REGISTERED PROFESSIONAL LAND SURVEYOR  
*G. Dennis Edwards*  
 OREGON  
 JULY 16, 1971  
 G. DENNIS EDWARDS  
 951  
 RENEWS 12/31/97

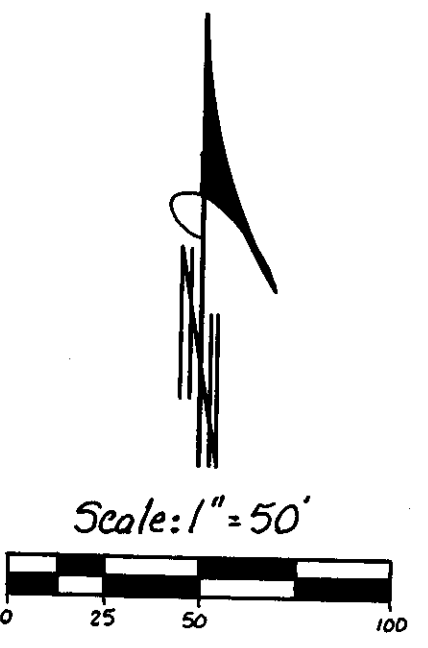

- LEGEND:**
- Found monuments, as noted.
  - Set 3/8" x 30" rebar with plastic cap #951.
  - △ Set Railroad Spike, stamped 951.
  - (000) of Record. Deed distances.

RECEIVED BY  
 Morrow County Surveyor  
 Date 6/21/96  
 Rec'd By SKB  
 No. C-1094-E (867)

Survey for **PAUL LANG**  
 In the NE 1/4, NE 1/4 of Section 34, T2S, R26E, W.1.M.,  
 Morrow County, Oregon.  
 6/19/20 Job #59604075  
 Edwards Surveying P.O. Box 763  
 541-567-3336 Hermiston, Oregon 97838