


BLOCK 30

BLOCK 29

RECEIVED BY
 Morrow County Surveyor
 Date 9/16/97
 Rec'd By SKB
 No. C-1141-E 915

NARRATIVE:
 THE PURPOSE OF THIS SURVEY IS TO STAKE THE FOUR CORNERS OF LOTS 6 AND 7, BLOCK 30, TOWN OF IRRIGON, TO SEE WHERE THE FENCES LIE IN RELATION TO THE LOT LINES.
 THE 1/2" IRON RODS IN CONCRETE WHICH I USED FOR THIS SURVEY WERE SET ABOUT THE YEAR 1960 BY AN UNKNOWN SURVEYOR IN AN UNRECORDED SURVEY FOR THE CITY OF IRRIGON. I BELIEVE THAT HE SET ALL BLOCK CORNERS IN THAT SURVEY AND THEY MATCH THE ORIGINAL PLAT QUITE WELL, EXCEPT FOR THE ONE AT THE NW CORNER OF LOT 12 WHICH I DID NOT USE BECAUSE IT DOES NOT MATCH THE OTHERS. I ASSUMED THE BEARING OF WASHINGTON AVENUE AS WEST.

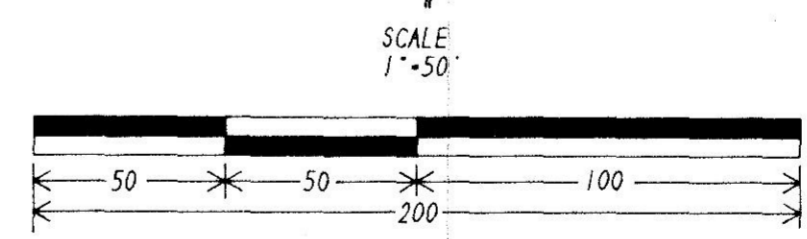

- FOUND 1/2" ROD IN CONC. I BELIEVE SET ABOUT 1960 BY AN UNKNOWN SURVEYOR FOR THE CITY OF IRRIGON.
- SET 5/8" X 30" REBAR WITH PLASTIC CAP # 951.

SURVEY FOR: RUTH SULLIVAN
 IN LOTS 6 AND 7, BLOCK 30, TOWN OF IRRIGON, IN THE SE 1/4 SECTION 24, T 5 N., R 26 E., W. M., MORROW COUNTY, OREGON
 9/4/97 JOB # S9708205
 EDWARDS SURVEYING, P.O. BOX 763 541-567-3336
 HERMISTON, OR 97838 FAX 567-7850