


LEGEND:

- Found rebar as noted.
- Set 5/8" x 30" rebar with plastic cap #951.
- (ooo) of Record. Plat of "SOUTH BOARDMAN" Subdivision by Harris.
- SURVEY REFERENCES:
 - (H) Plat of SOUTH BOARDMAN by Harris.
 - (E) My 1994 survey for PTI Communication.
 - Computed location. Did not set.

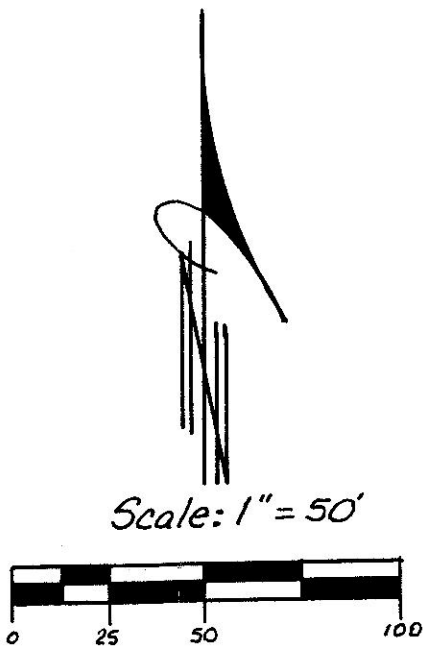

NARRATIVE:

The purpose of this survey is to do a lot line adjustment on two tax lots (800 and 801, 4N 25 9CC) described as parcels one and two in a deed to Hopkins and Sons, recorded on M-38614, Morrow County Deed Records. Before and after this lot line adjustment both of these parcels combined are lot 5 of "SOUTH BOARDMAN," an addition to the City of Boardman, Morrow County, Oregon. I found all of lot 5's corners except the Northeast one. I set the new corners on the South and North lot lines as instructed by Joe Hopkins to separate a mobile home and garage from a duplex.

REGISTERED
 PROFESSIONAL
 LAND SURVEYOR

G. Dennis Edwards

OREGON
 JULY 18, 1971
 G. DENNIS EDWARDS
 951
 RENEWS 12/31/97

RECEIVED BY
 Morrow County Surveyor
 Date 9/18/97
 Rec'd By SKB
 No. B-1143-E (917)

Survey for JOE HOPKINS
 In Lot 5, Block 1, "SOUTH BOARDMAN,"
 In SW 1/4 Section 9, T4N, R25E, W.M.,
 City of Boardman, Morrow County, Oregon
 9/17/97 Job #59708188
 Edwards Surveying P.O. Box 763
 541-567-3336 Hermiston, Oregon 97838