


THE PURPOSE OF THIS SURVEY IS TO LOCATE THE CORNERS OF THE MAIN PARCEL OF THAT TRACT OF LAND DEEDED TO BRIAN BUTLER, ET UX, ON M-50763 MORROW COUNTY DEED RECORDS, FOR A PENDING SALE

I SURVEYED THIS PARCEL IN A 1987 SURVEY FOR BYRON GROW AND RETRACED THAT SURVEY TO REPLACE THE MISSING CORNERS.

I DID NOT SURVEY THAT PORTION OF SAID BUTLER PARCEL WHICH IS A 45 FOOT STRIP RUNNING FROM THE SW CORNER OF THE MAIN PORTION ABOUT 190 FEET WESTERLY TO WHAT WAS TWENTYTHIRD STREET. THE NORTH LINE OF SAID 45 FOOT STRIP IS THE SOUTH LINE OF THE SUBDIVISION OF PART OF SECTION 21 AND I BELIEVE THERE IS A FENCE LINE WHICH RUNS ALONG REASONABLY CLOSE TO SAID NORTH LINE.

LEGEND:

- 1/2" IRON REBAR FOUND
- Ⓐ WALLUIS 1958 SURVEY FOR JONES
- Ⓑ MY 1977 SURVEY FOR JONES
- Ⓒ MY 1987 SURVEY FOR GROW
- 5/8" X 30" IRON REBAR SET WITH PLASTIC CAP #351
- (OOO) OF RECORD MY 1987 SURVEY FOR GROW

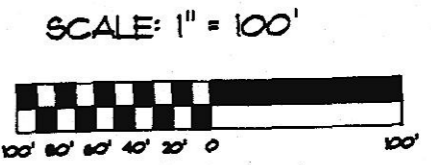

REGISTERED
PROFESSIONAL
LAND SURVEYOR

G. Dennis Edwards

OREGON
JULY 16, 1971
G. DENNIS EDWARDS
951

RENEWS 12/31/99

RECEIVED BY
Morrow County Surveyor
Date 8-98
Rec'd By LC
No. B-1185-E (759)

SURVEY FOR BRIAN BUTLER C/O ALL STAR REALTY
IN SE 1/4, NE 1/4 SEC. 21, T5N, R27E, W.M.
MORROW COUNTY, OREGON
8/10/98 JOB NO. 59807167
EDWARDS SURVEYING P.O. BOX 763
541-567-3336 HERMISTON, OR 97838
DRAWN BY: LLC

