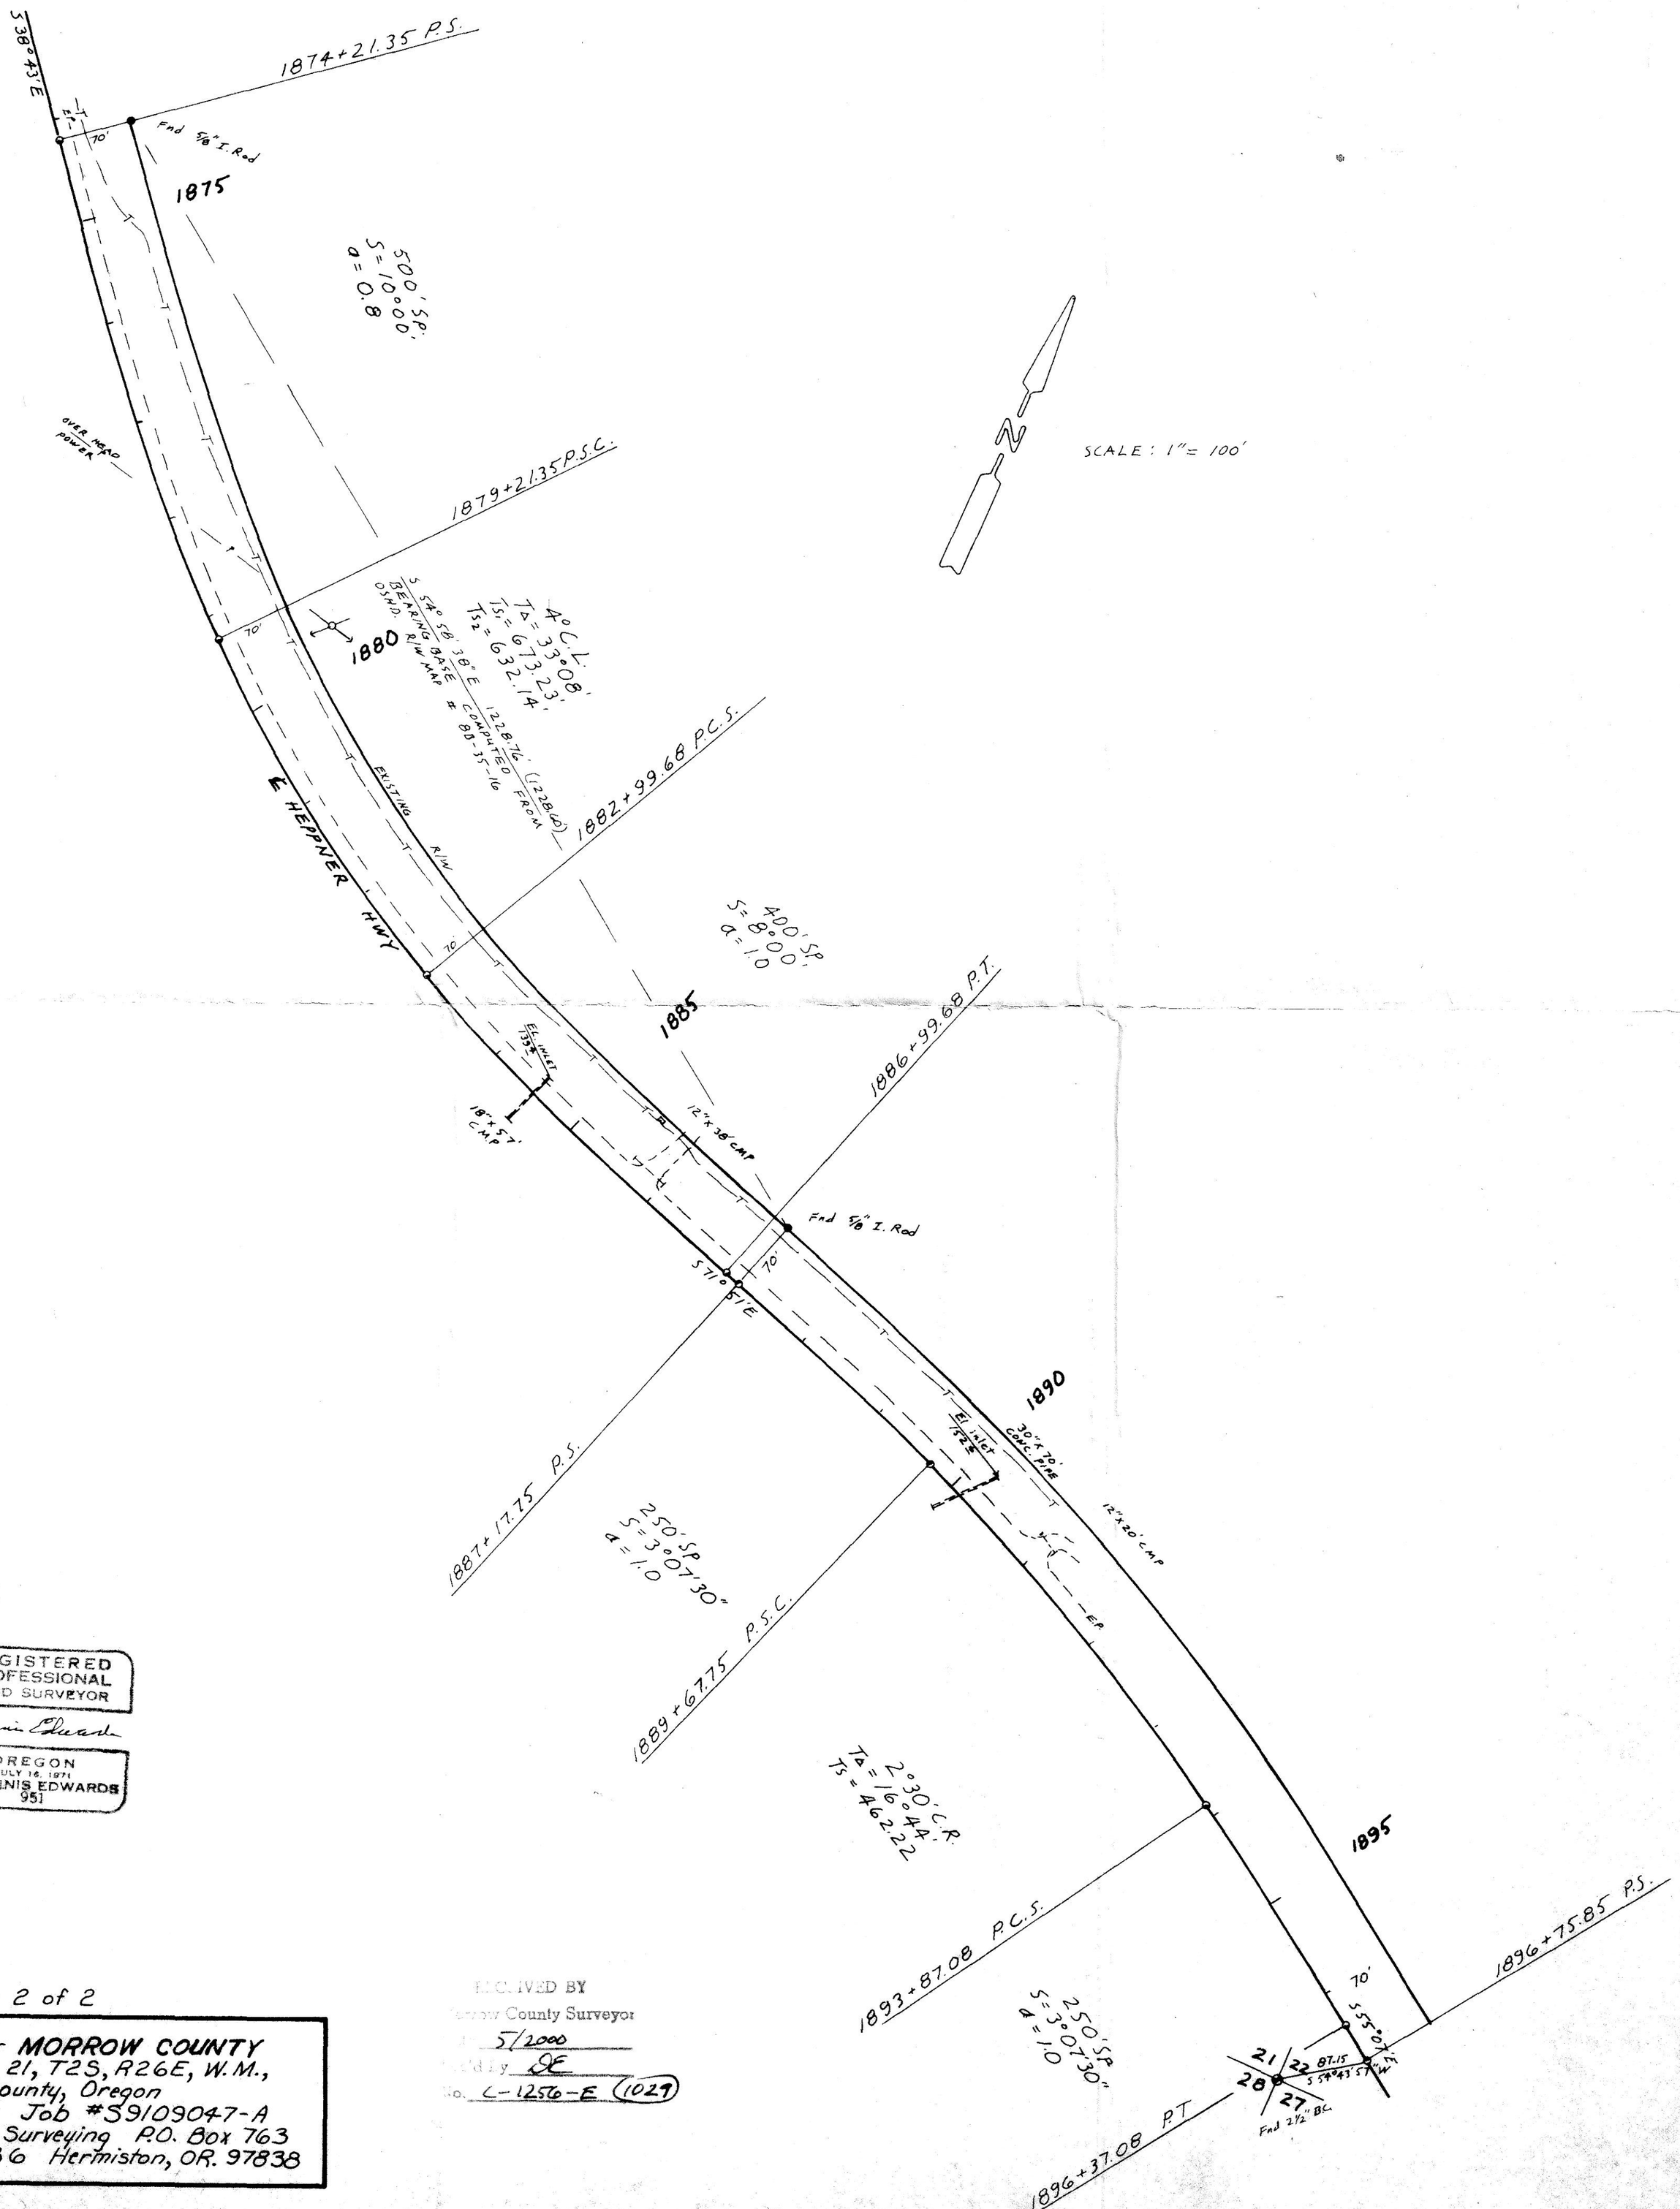

REGISTERED PROFESSIONAL LAND SURVEYOR

G. Dennis Edwards

OREGON JULY 16, 1971 G. DENNIS EDWARDS 951

RECEIVED BY
Morrow County Surveyor
Date 5/2000
Filed by DE
No. C-1256-E (1029)

Sheet 2 of 2

Survey for **MORROW COUNTY**
In Section 21, T2S, R26E, W.M.,
Morrow County, Oregon
5/1/92 Job #S9109047-A
Edwards Surveying P.O. Box 763
567-3336 Hermiston, OR. 97838