


**NARRATIVE:**

THE PURPOSE OF THIS SURVEY IS TO RECORD A MAP OF A SUBDIVISION I STAKED IN 1976 BUT NEVER GOT RECORDED. THAT SUBDIVISION WAS GOING TO BE CALLED "RIVERVIEW ESTATES" AND A PLAT WAS DRAWN ON HARDBOARD WHICH WAS IN USE AT THAT TIME. THAT HARDBOARD HAS BEEN LOST SO I DRAFTED THIS MAP FOR FILING. THESE LOTS WERE SOLD BY METES AND BOUNDS DESCRIPTIONS WITH REFERENCE TO THE NE CORNER OF THE SE 1/4 OF THE NE 1/4 OF SECTION 21.

**LEGEND:**

- MONUMENTS FOUND
- Ⓐ 1/2" IRON REBAR ORIG UNKNOWN
- Ⓑ 5/8" IRON REBAR ME 1976 SURVEY FOR E.M.L. & MAX JONES
- SET 1/2" X 24" IRON REBAR
- ⊙ SET 5/8" X 30" IRON REBAR

RECEIVED BY  
 Morrow County Surveyor  
 Date 12/2000  
 Rec'd By DE  
 No. C-1278-E (1051)

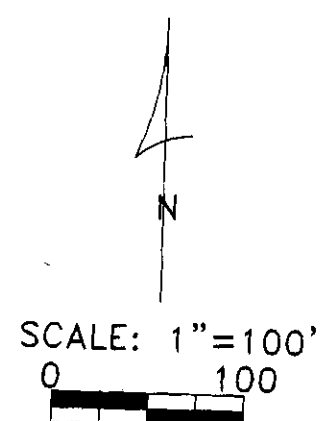

REGISTERED  
 PROFESSIONAL  
 LAND SURVEYOR  
*G. Dennis Edwards*  
 OREGON  
 JULY 16, 1971  
 G. DENNIS EDWARDS  
 RENEWS 12/31/2001

SURVEY LINNELL & WILEY  
 IN SEC. 21, T 5 N, R 27 E, W.M.,  
 MORROW COUNTY, OREGON  
 2/22/2000 JOB# 7603053  
 EDWARDS SURVEYING P.O. BOX 763  
 541-567-3336 HERMISTON, OREGON 97838  
 DRAWN BY NJF

1051