

NARRATIVE:

THE PURPOSE OF THIS SURVEY IS TO LOCATE AND OR SET THE CORNERS OF LOT 2 BLOCK 10 "COLUMBIA TERRACE" SO A MANUFACTURED HOME CAN BE SITED WITH THE PROPER SETBACKS. I DID THE SAME THING ON LOT 2 BLOCK 11 FIRST THINKING IT WAS BLOCK 10. IT WAS THE WRONG LOT BUT I LEFT THE MONUMENTS IN ANY WAY.

I BASED THE BEARINGS OF THIS SURVEY ON ROGERS' 1976 PLAT AND SET THE MISSING CORNERS BY RETRACING THE PLAT FROM THE 5 MONUMENTS THAT I FOUND.



SCALE: 1"=50'


REGISTERED
PROFESSIONAL
LAND SURVEYOR

G. Dennis Edwards

OREGON
JULY 16, 1971
G. DENNIS EDWARDS
9 5 1
RENEWS 12/31/2001

SURVEY FOR LEWIS, C/O AMERITITLE
IN BLOCKS 10 & 11, "COLUMBIA TERRACE",
CITY OF BOARDMAN, IN NE 1/4, SEC. 17, T 4 N,
R 25 E, W.M., MORROW COUNTY, OREGON
8/30/2000 JOB# S0008175
EDWARDS SURVEYING P.O. BOX 763
541-567-3336 HERMISTON, OREGON 97838
DRAWN BY NJF

RECEIVED BY
Morrow County Surveyor
Date 12/2000
Rec'd By DE
No. B-1280-E (1053)

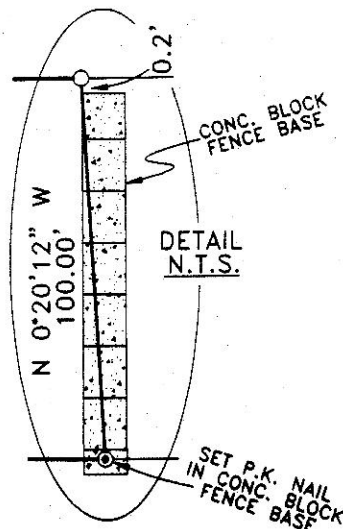

- LEGEND:**
- FOUND 5/8" IRON REBAR, ROGERS' 1976 PLAT OF "COLUMBIA TERRACE"
 - SET 5/8"X30" IRON REBAR WITH PLASTIC CAP #951