


NARRATIVE:

THE PURPOSE OF THIS SURVEY IS TO LOCATE AND OR SET THE CORNERS OF LOT 5 BLOCK 2 "COLUMBIA TERRACE" SO A MANUFACTURED HOME CAN BE SITED WITH THE PROPER SETBACKS. I BASED THE BEARINGS OF THIS SURVEY ON ROGERS' 1976 PLAT OF "COLUMBIA TERRACE" AND SET THE MISSING CORNERS BY RETRACING THE PLAT FROM THE MONUMENTS THAT I FOUND.

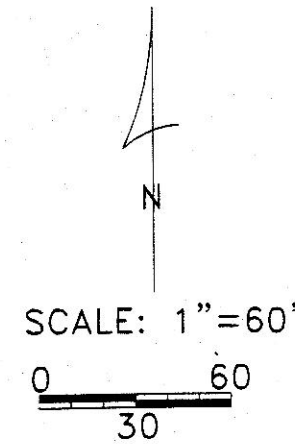

REGISTERED
PROFESSIONAL
LAND SURVEYOR

G. Dennis Edwards

OREGON
JULY 16, 1971
G. DENNIS EDWARDS
9 5 1
RENEWS 12/31/2001

SURVEY FOR TURN KEY HOMES (SKINNER)
IN LOT 5, BLK. 2, "COLUMBIA TERRACE",
CITY OF BOARDMAN, IN NE 1/4, SEC. 17, T 4 N,
R 25 E, W.M., MORROW COUNTY, OREGON
9/10/2000 JOB# S0008179
EDWARDS SURVEYING P.O. BOX 763
541-567-3336 HERMISTON, OREGON 97838
DRAWN BY NJF

LEGEND:

- FOUND 5/8" IRON REBAR, ROGERS' 1976 PLAT OF "COLUMBIA TERRACE"
- SET 5/8" X 30" IRON REBAR WITH PLASTIC CAP #951

RECEIVED BY
Morrow County Surveyors
Date 12/2000
Rec'd By DE
No. B-1282-E (1055)