




SCALE: 1" = 300'

LEGEND

- --- FOUND IRON PIN
- --- SET 1/2" φ IRON PIN

FD. I. PIPE
W/BRASS
WASHER

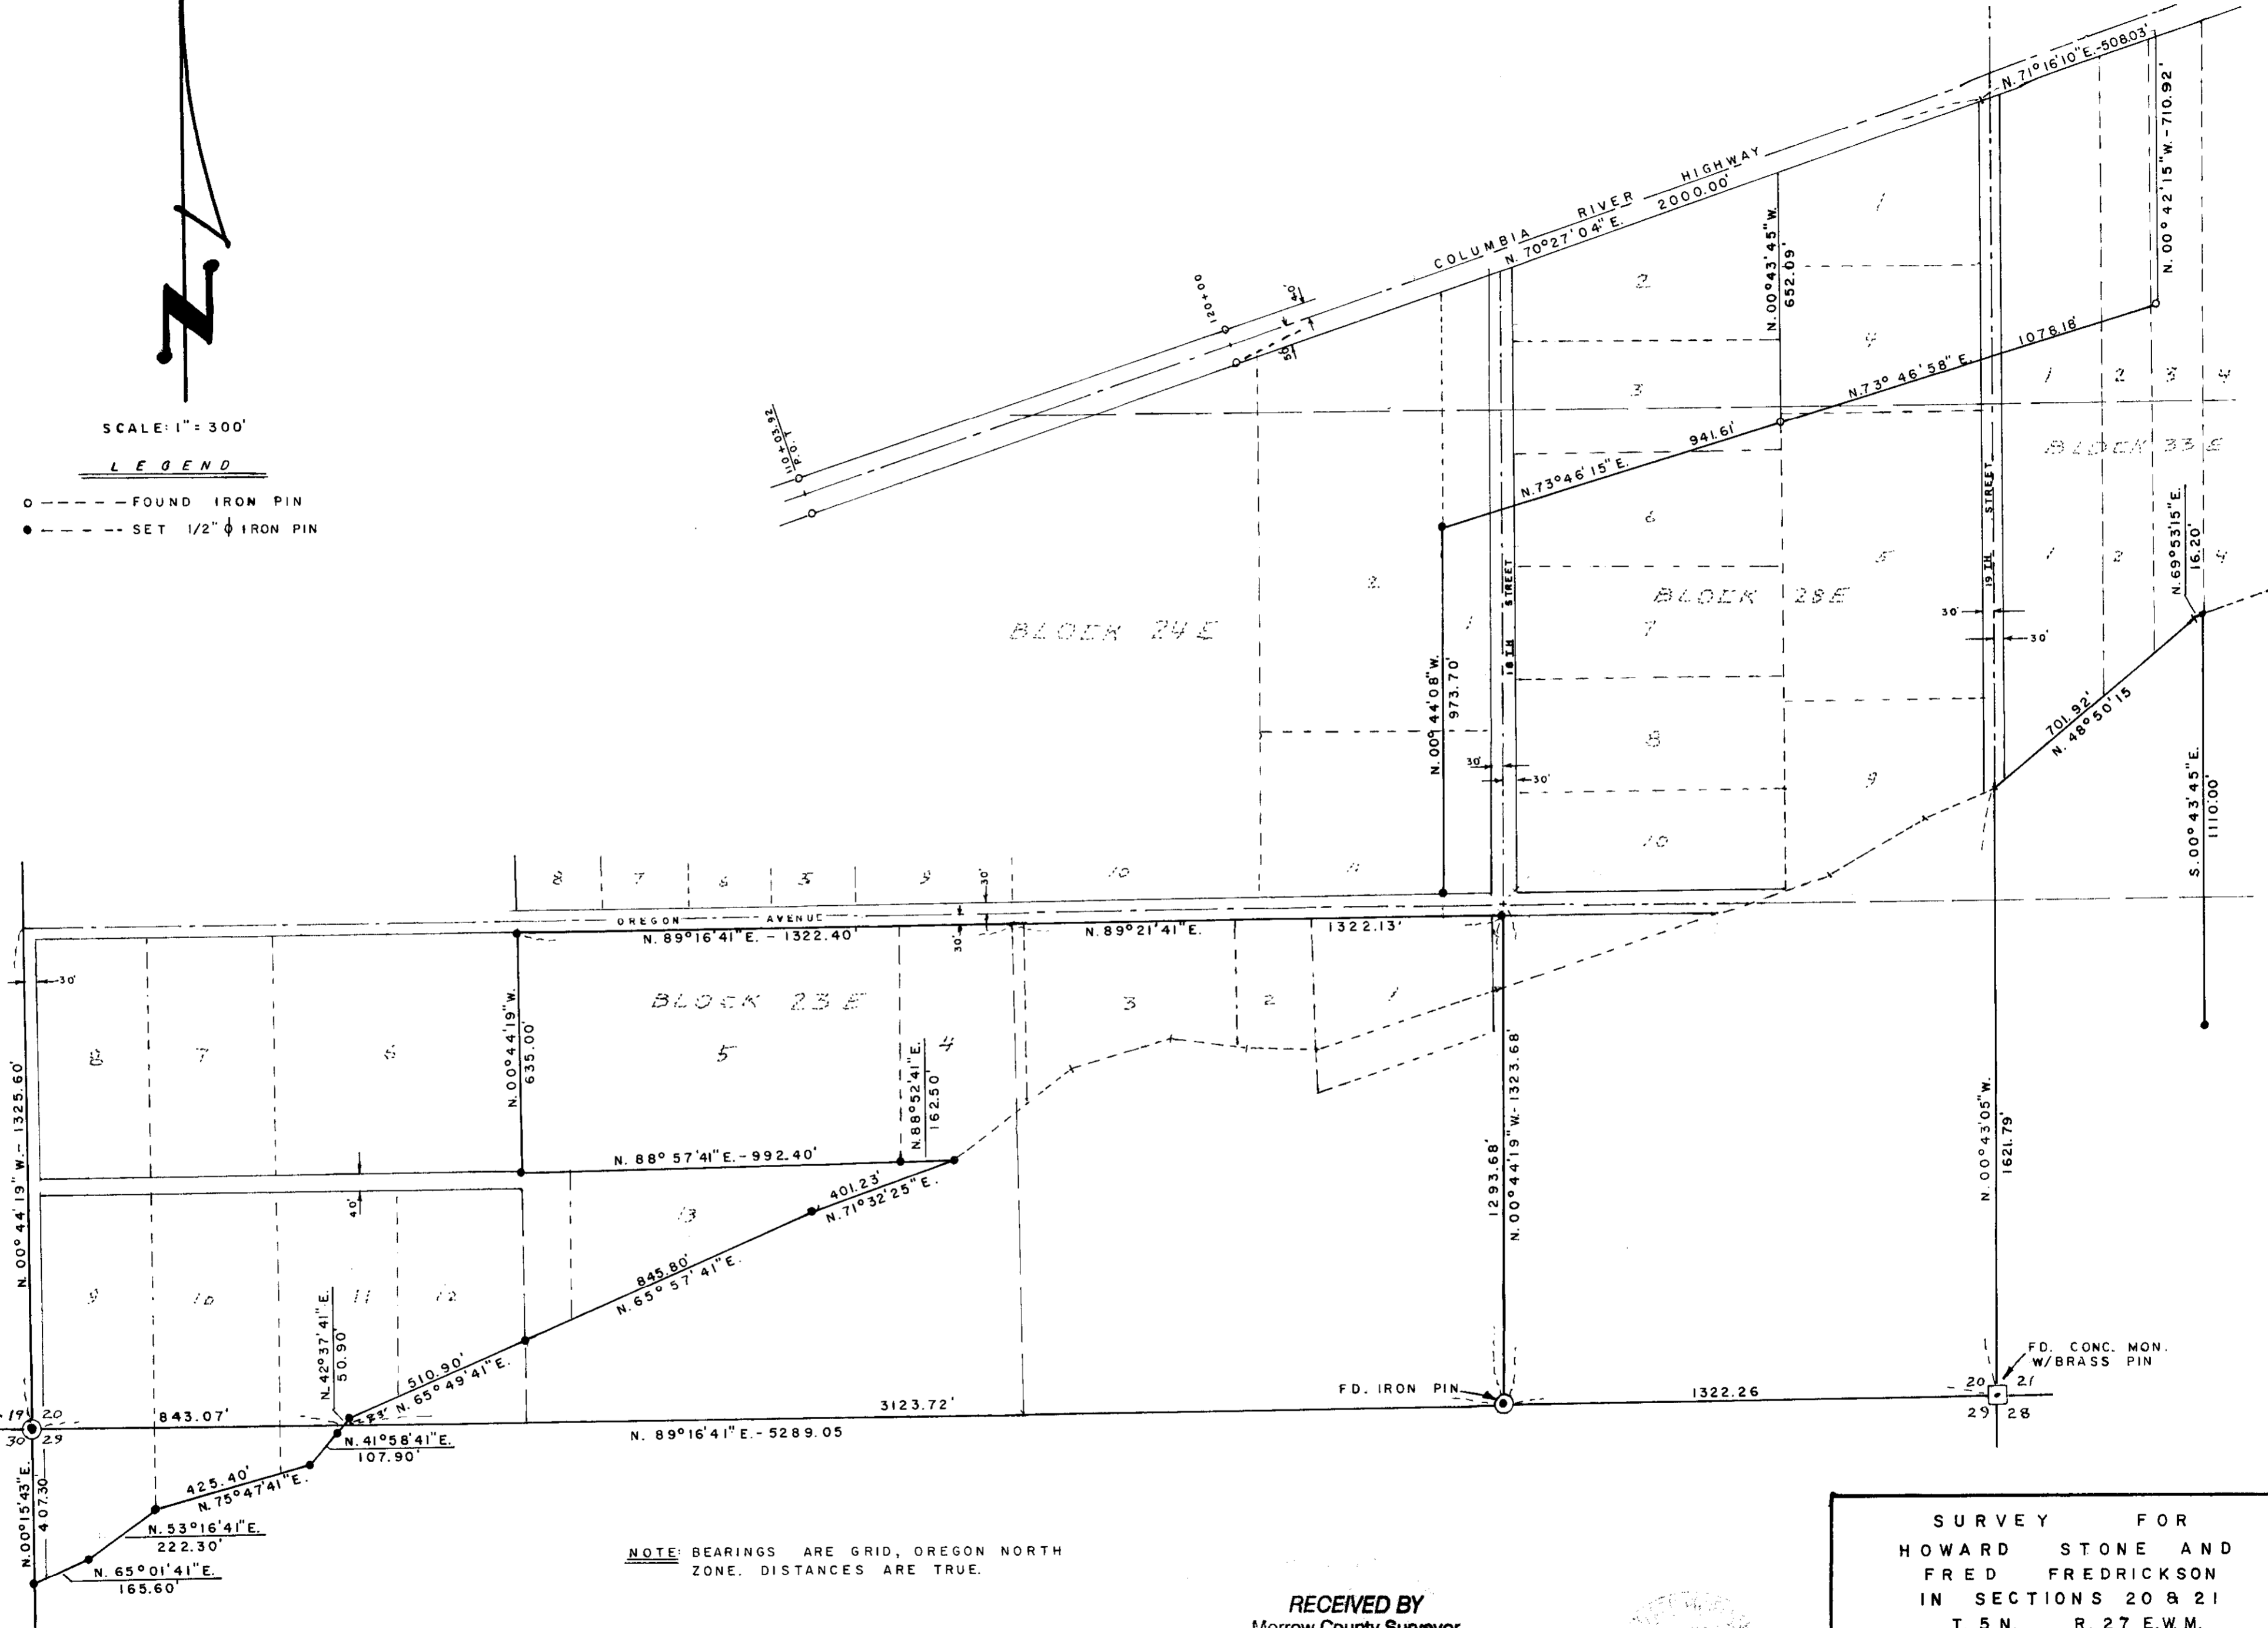

NOTE: BEARINGS ARE GRID, OREGON NORTH ZONE. DISTANCES ARE TRUE.

RECEIVED BY
Morrow County Surveyor

Date: 1-25-2013
 Rec'd By: SKH
 No.: 2013-10C
 Folder No.: 1066



SURVEY FOR HOWARD STONE AND FRED FREDRICKSON IN SECTIONS 20 & 21 T. 5 N. R. 27 E.W.M.		
DRWN. BY: H.F.S.	DATE: 4-15-75	SCALE: 1" = 300'
DONALD L. STAEBLER CONSULTING ENGINEER P.O. BOX 91 PENDLETON OREGON 97801		