lot Survey for.

Haskell Sharrard
Box 625 (575 N. Jones).
Heppner, Ore.
home 676-5846
off. 676-9975 WE TV. Shop

in NW¼ SW¼ Sec. 35. T2S. R26

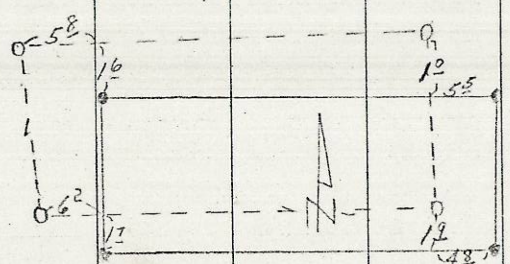

"•" Iron pins Set
"O" " " Fnd.

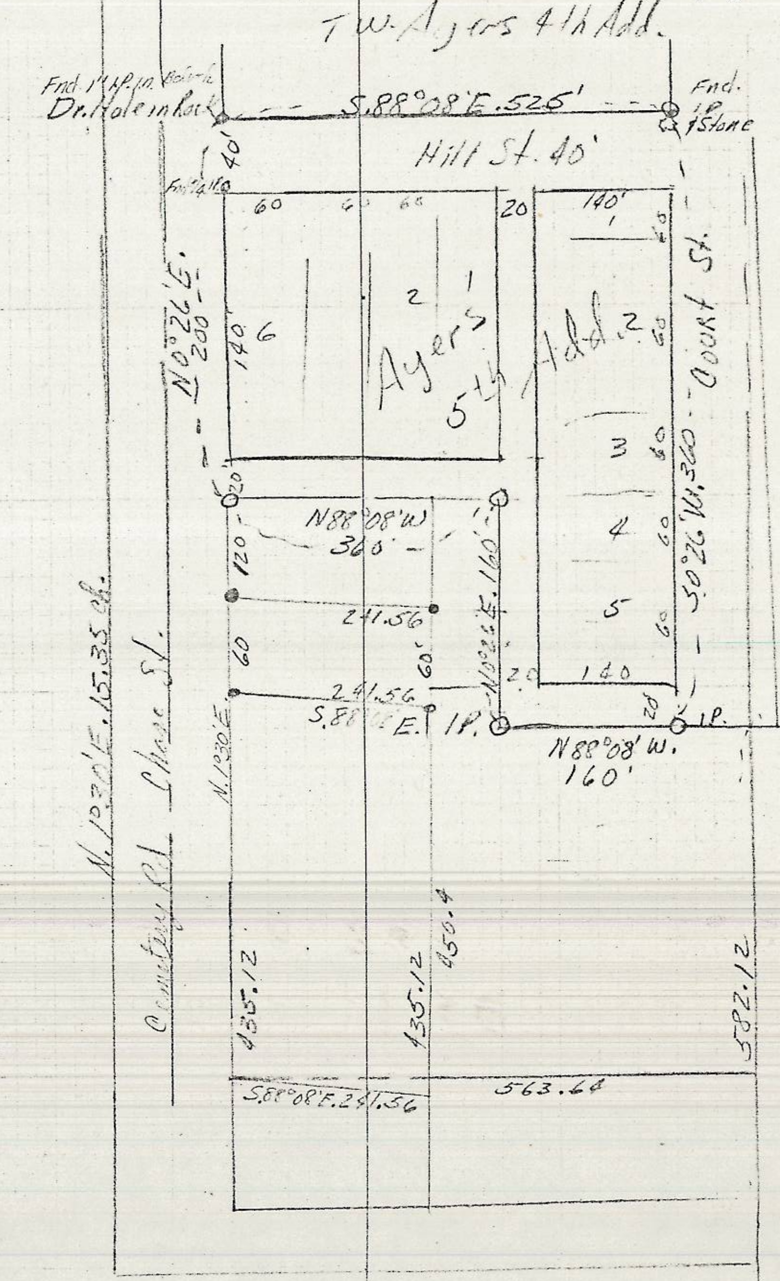

RECEIVED BY
Morrow County Surveyor
Date: 2-7-2013
Rec'd By: S.K.H
No.: 2013-18A
Folder No.: 1073