NARRATIVE:

Purpose of this survey was to set property corners on a 50 foot strip immediately adjacent to and South of North Main Avenue in the East half of the Southwest quarter of the Southwest quarter of Section 19, T. 5 N, R 27 E, W.M. between Tenth and Twelfth Street. At the instructions of Matt Doherty, this was measured perpendicular to Main Ave. Numerous points were found immediately adjacent to this parcel and around the school property as shown on the map. Bearings are based on control surveying done for Morrow County using the South line of Section 23, T. 5 N., R 26 E., W.M. as shown on the 1935 plats by Tamblyn.

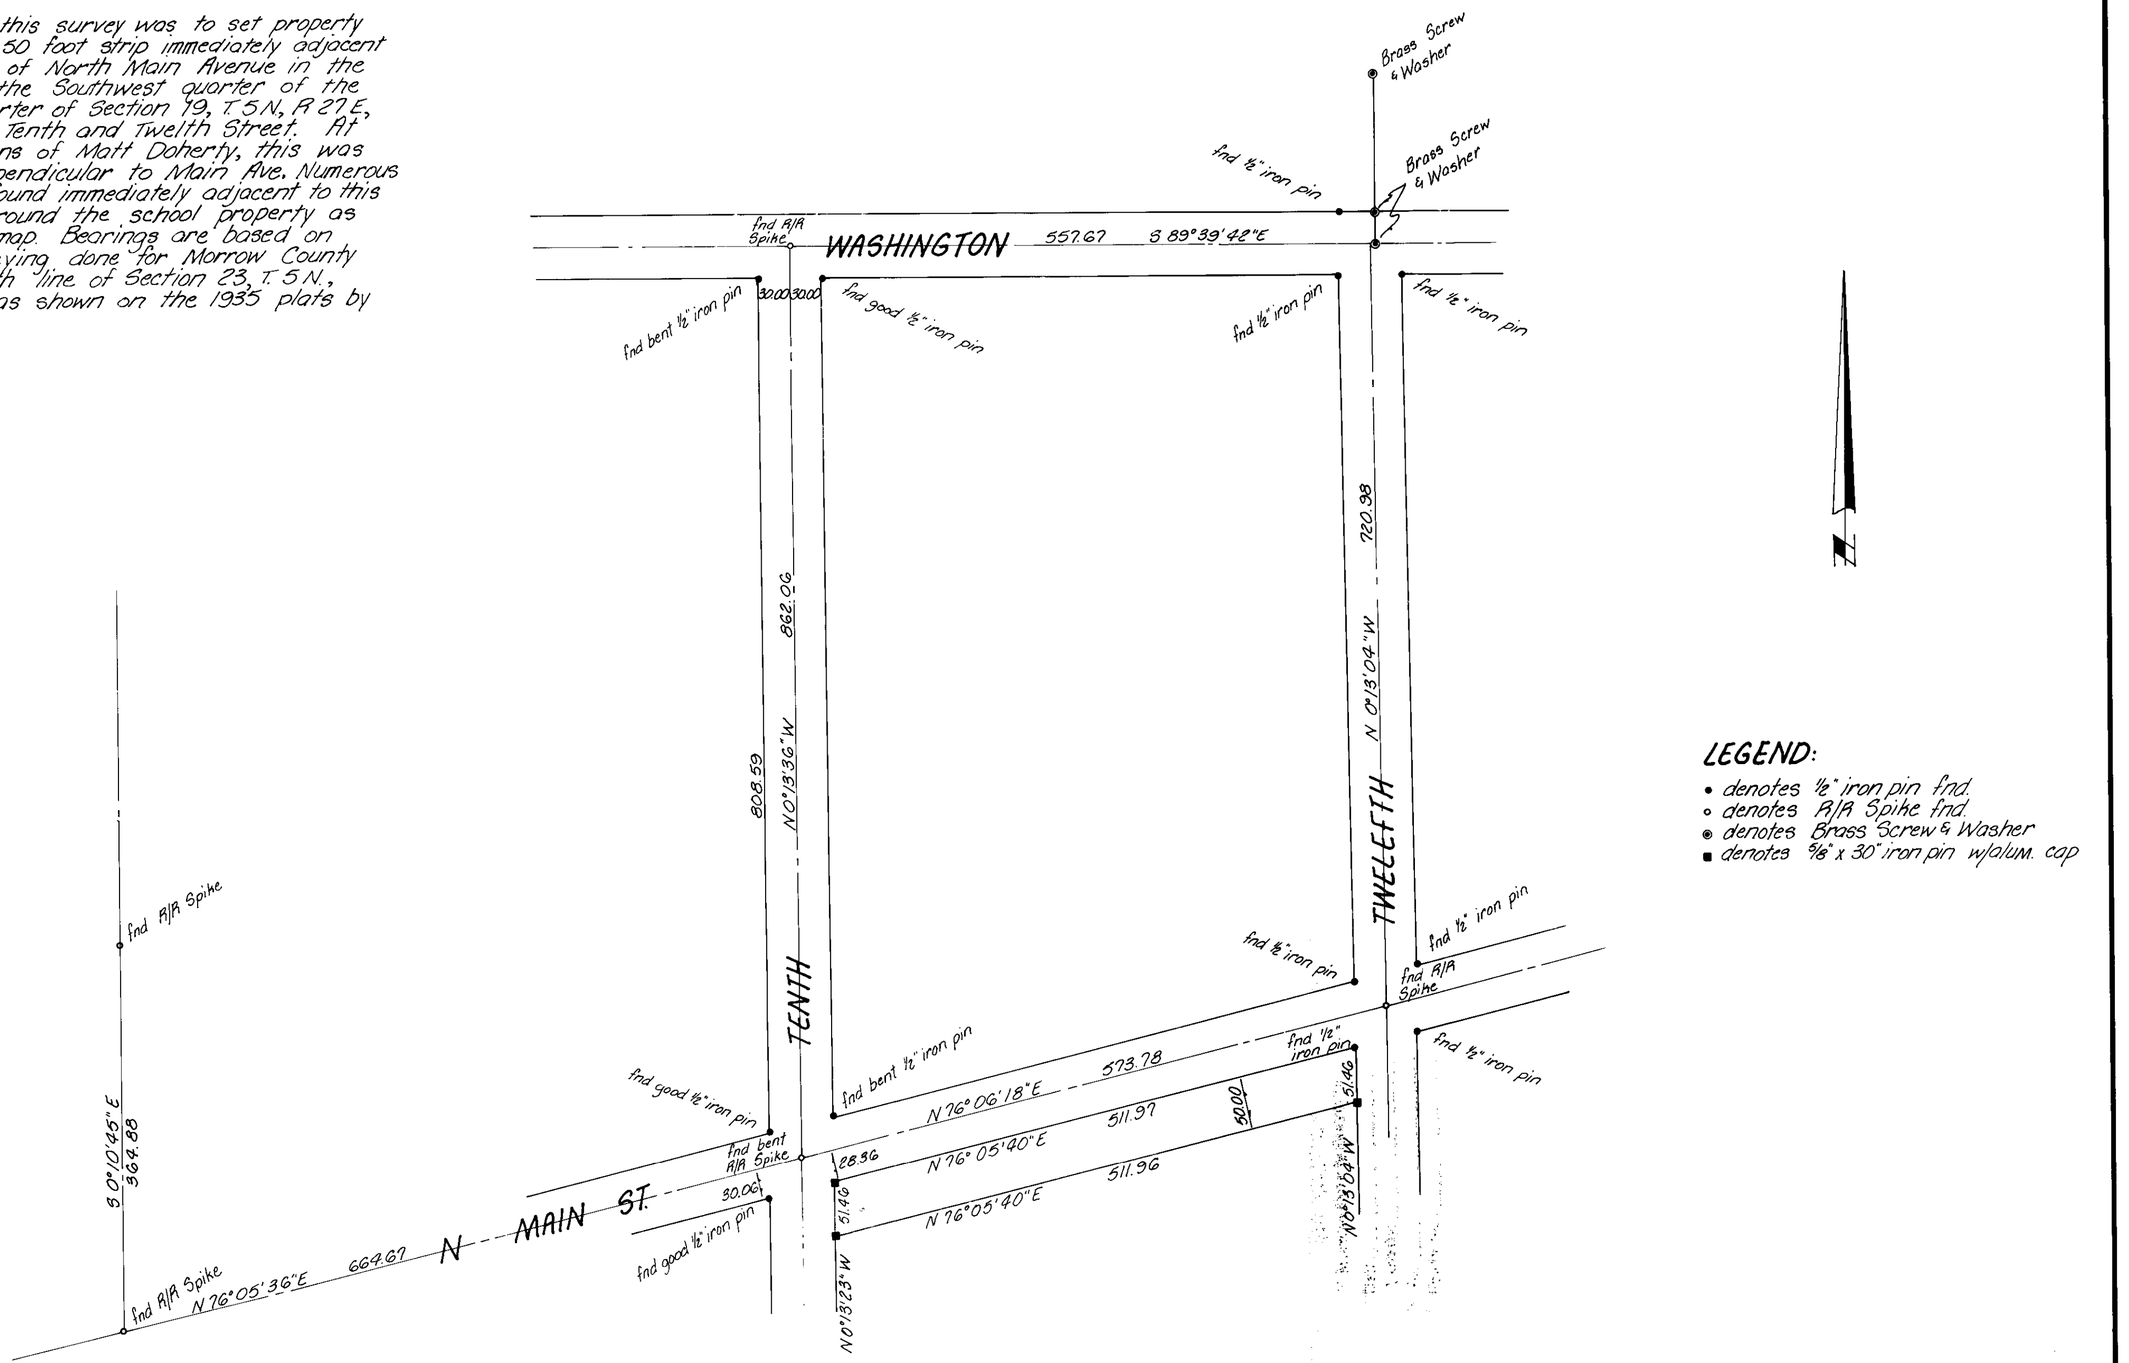

LEGEND:

- • denotes ½" iron pin fnd.
- ○ denotes A/A Spike fnd
- ◉ denotes Brass Screw & Washer
- ■ denotes ⅝" x 30" iron pin w/alum. cap

REGISTERED PROFESSIONAL LAND SURVEYOR
David H. Klein

2-21-83
MLD
C-525-K

KRUMBEIN ENGINEERING CO. ENGINEERS – SURVEYORS – PLANNERS 221 S. Main, Pendleton, Oregon	SCALE 1" = 100'
	DATE 1-21-83
Survey for MORROW COUNTY SCHOOLS Sec. 19, T5N, R27E	DRN. BY MLD
	CKD. BY DHK
	DRNG. NO. 83-01C

Folder #1076 Job No. 83-04

107A