

Oct. 23, 1921.

Abingdon Dec. 16, Sp. 4M.

R. 25 E 2000.

Near J. M. Kelly claim
G. W. Moore claim
C. T. Mulvey, Flagman

Set up on cut to Sec. 15-16-21-22

Sp. 4 M. R. 25 E. N. M.

Run about 200' to

20.00 ch set trap for 4 cor.

20.635

39.56 ch find 1/4 on foot on line 4x4
sets Jan 7x14x20 on south
side of foot 6" out of ground.

Flag North and South
Circuit line also East
and West circuit line
and draw 1 1/2" from paper
2 ft long at party
selected for 4 cor.

2139.52

19.78

Book 10

24.636

19.78

18.55

66

51.30

51.30

56.430

41.07

4159.5422

9.856

Line to cor to Sec. 16-17-20-21

subd 1/4 S 20 E. 14 S 16 W N.

$$\begin{array}{r} 8) 39425 \\ \underline{4928} \\ 14784 \end{array}$$

$$\begin{array}{r} 1500 \\ \underline{14784} \\ .216 \end{array}$$

$$\begin{array}{r} 139425 \\ \underline{19} \\ 1957 \\ \underline{19713} \\ 48 \end{array}$$

set up at 44 on at center
 of section and run
 to flag 1/4 on on
 39425th. east side of Sec. 16

15.00 set stakes

20.00 set trap 4/4 on

39425th the 1/4 on 2nd
 Secs 15-7-16,

8183 34
Book 10
103
5
15

813213
7896
5
24.480

Set up in 1/4 car at center of line
16. Sp. 2A Res. E.
2002 set trap 1/4 car.

40.22.56 The 1/4 car set Res. 9 x 16.

Return and at
20.112 set 1/4 corner.

Set up in 1/4 car between 16 x 15. Sp. 4M Res. E.
Run with no direct line to the car.
20.10 set trap 1/4 corner.

40.17 ch. The car to Dec. 89-15-16.

Set up in cut to Dec. 189-15-16
inverts plugged 1/4 car set. 9 x 16

20.07 ch. set trap 1/4 car.


24.07 ch. make 2 ch. spent to events

25.07 ch. set trap 3/6 car.

at. 1/6 car. at. a spot 2 x 6"

39.17 ch. ~~at~~ the 1/4 car at spot 2 ch. next.

Return and at 20.085 set 1/4 car.

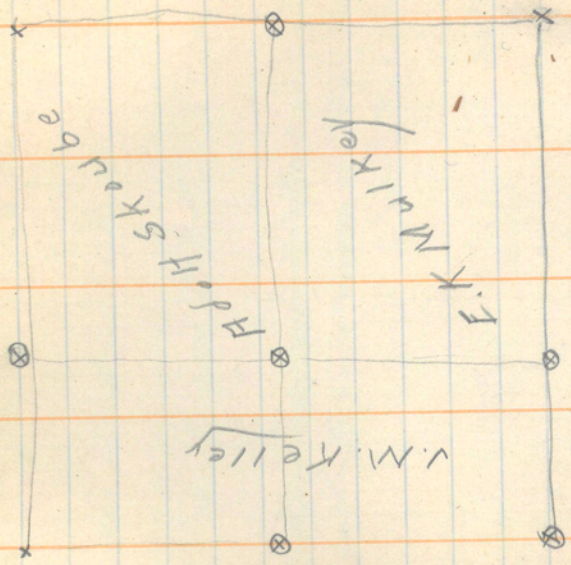

Cost of Survey

3 days at 10	30.00	
Mileage 1/2	6.00	
	<hr/>	
	36.00	
6 corners set		
Cost per corner	6.00	
Murphy 2 corners	12.00	
Kelley 2 1/2 corners	15.00	
Complete 1 cor	6.00	
		58.00