

Friday Mar 7 1924

Flag line from Cut to Secs
 7-18-13, Sp. 1 A R 26-27 E.
 to 1/4 cor between Secs.
 192 24, Sp. 1 A R 26 & 27 E.

Begin at the Cut to 7-18-12-13
 and measure South
 23.00 ch across and Hollow

40.00 ch set line 1/4 cor

81.00 ch set line on to Secs

93.00 ch to stake in center of to Road

120.16 ch to 1/4 cor bet Secs. 19 & 24,

Sp. 1 A R 26 & 27 E. 7 M.

38
Book 18

Return on the line and
at 40.05 $\frac{1}{2}$ set a stone
8 x 2 x 20 rocks 111 on N x S side
E S on west + on top
set on top is 6" below ground
glass and sky light glass in
bottom of hole, 20 steps from Red Cr. 1/2 north

At 80.10 $\frac{3}{4}$ set a stone, pear shaped,
10 x 10 x 15 inches $\frac{1}{4}$ E S on West side
and + on top. 10 meters below surface
A ground in wheat field.

39
Book 18

40

Set up in C. to Run 19-22-13-18

By 1st R 26x 27 E

East 4.4 Hd

N 20° 27' E, 27.13 ch.

N 16° 49' W, 15.255 ch.

West 9.45 ch to 1/4 corner Not Acco. 19x24


South 40.06

N 20° 27' E 27.13
Sout Surf

$$\begin{array}{r} 238 \\ 2713 \\ \hline 2814 \\ 938 \\ 6566 \\ 1876 \\ \hline 2544794 \end{array}$$

N 16° 49' W 15.25

$$\begin{array}{r} 958 \\ 1525 \\ \hline 4490 \\ 1916 \\ 4990 \\ 958 \\ \hline 1460950 \end{array}$$

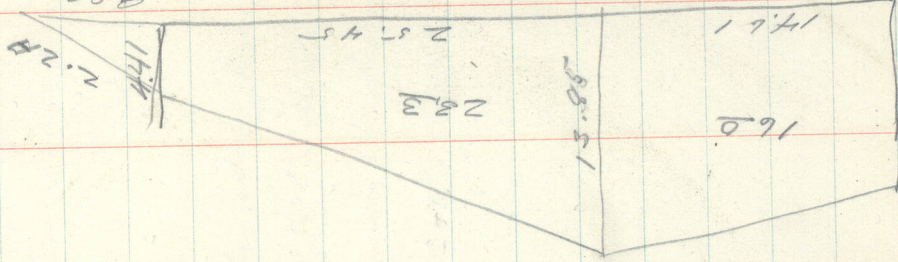

N 20° 27' E
27.13

E 4.4 Hd

S 40.06

W 9.45













41

N 25° 45'

14.61

25.45

40.06

40.06

40.06

13.85

13.84

13.85

4.41

2118.226

9.13

212330

11.65

14.61

11.65

5990

4260

1165

1602065

22905

2323585

4.91

441

491

1964

1964

216531













