


10/12/23

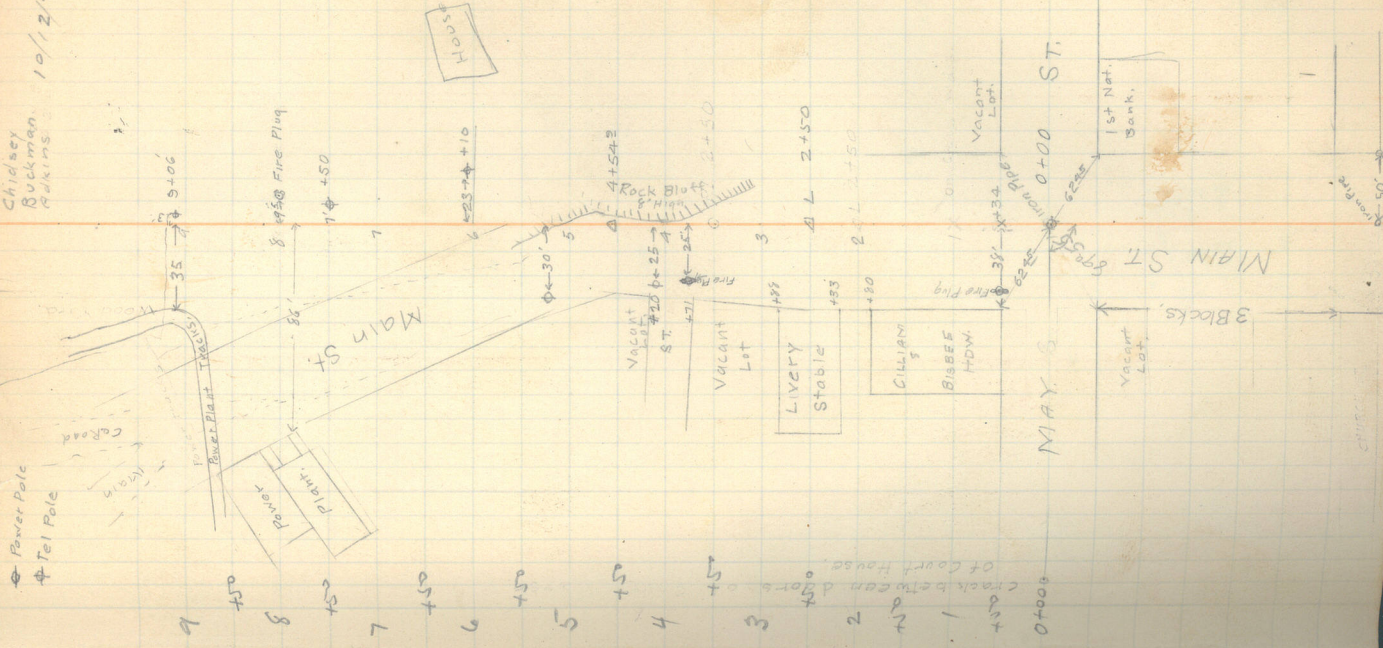

0+00 Iron Pipe Intersection at Main May Sts

Chidsey
13 Wickham
Adkins

5 Book 29

10/12/23

