


**RECORD of SURVEY for  
Paul & Phyllis Danielson  
585 Gayle Street  
Heppner, Oregon 97836**

RECEIVED BY  
Morrow County Surveyor  
Date 01/01/01  
Rec'd By RJM  
No. B-1293M  
Folder No. 1293

T. 2 S., R. 26 E., W.M., Section 26  
Southwest 1/4 of the Southwest 1/4

**NARRATIVE:**

The purpose of this survey was to establish the property lines of the Danielson's Lot. I located a few of the monuments in the area as shown on this survey. I then established the Lot corners according to the Found Monuments and a reconstruction of the two subdivisions, Johnson Addition & P. Looney's Addition to the City of Heppner. I used the Center Line of Gale Street as the Basis of Bearing and set the two westerly Lot corners as requested by the Danielsons. I have shown the calc'd locations of the remaining corners.

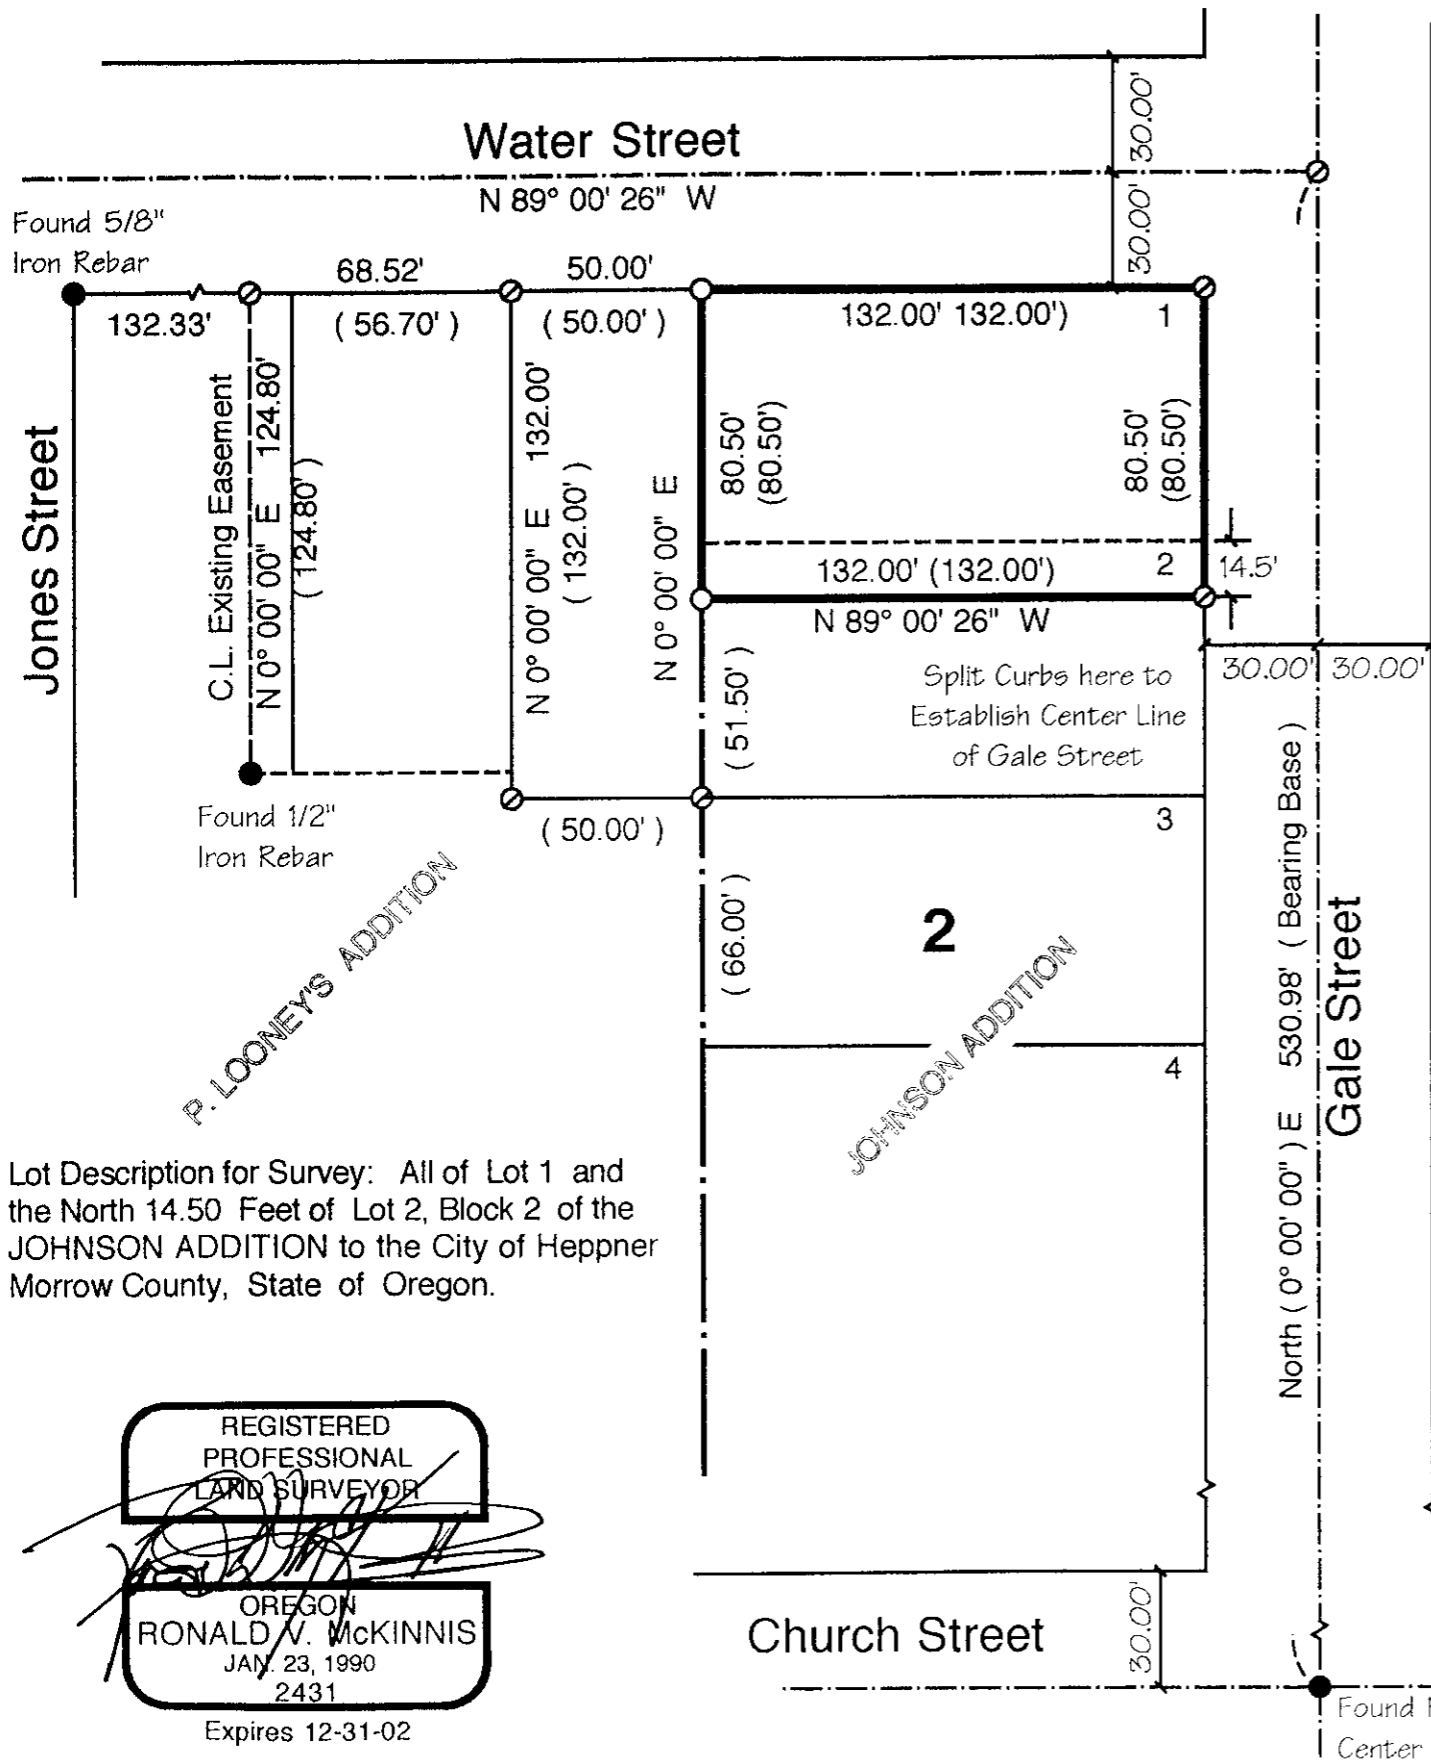

Found 5/8" Iron Rebar

Jones Street

Water Street

N 89° 00' 26" W

C.L. Existing Easement  
N 0° 00' 00" E 124.80'  
(124.80')

Found 1/2" Iron Rebar

P. LOONEYS ADDITION

JOHNSON ADDITION

Lot Description for Survey: All of Lot 1 and the North 14.50 Feet of Lot 2, Block 2 of the JOHNSON ADDITION to the City of Heppner Morrow County, State of Oregon.

REGISTERED PROFESSIONAL LAND SURVEYOR  
*[Signature]*  
OREGON  
RONALD V. MCKINNIS  
JAN. 23, 1990  
2431

Expires 12-31-02

Church Street

Found PK @ the Center of Intersection

**LEGEND**

- SET MONUMENTS - 5/8" x 30" Iron Rods W/ Plastic Caps Stamped - L.S. # 2431
- FOUND MONUMENTS - as Noted
- STREET C.L. and/or SECTION LINE
- ⊙ CALCULATED POINTS - Not Set
- LOT BOUNDARY
- ( 000 ) RECORD DISTANCE - Johnson Addition & P. Looney's Addition



SCALE 1" = 50 Ft.  
December, 2000

ENGINEERING - LAND SURVEYING - WATER RIGHTS  
**R. V. MCKINNIS ENGINEERING**  
79980 Prindle Loop Road  
Hermiston, Oregon 97838  
(541) -567-2017