
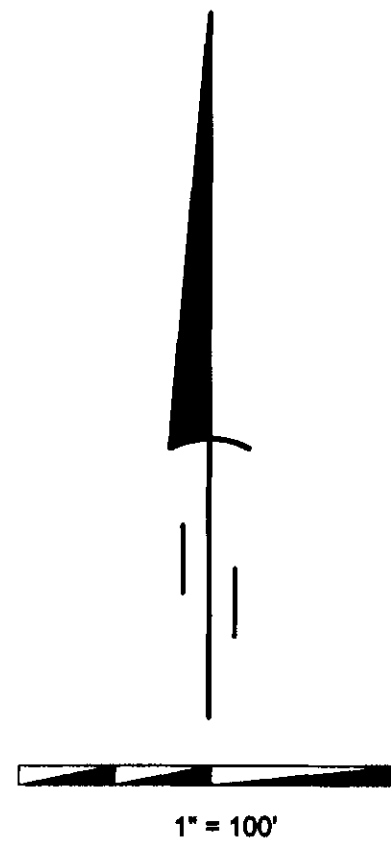


# RECORD OF SURVEY

SOUTH 150 FEET OF THE NORTH 300 FEET  
OF LOT 5, BLOCK 20 WEST  
IN THE NW 1/4, SEC 25, T5N, R26 EAST OF THE W.M.  
MORROW COUNTY, OREGON

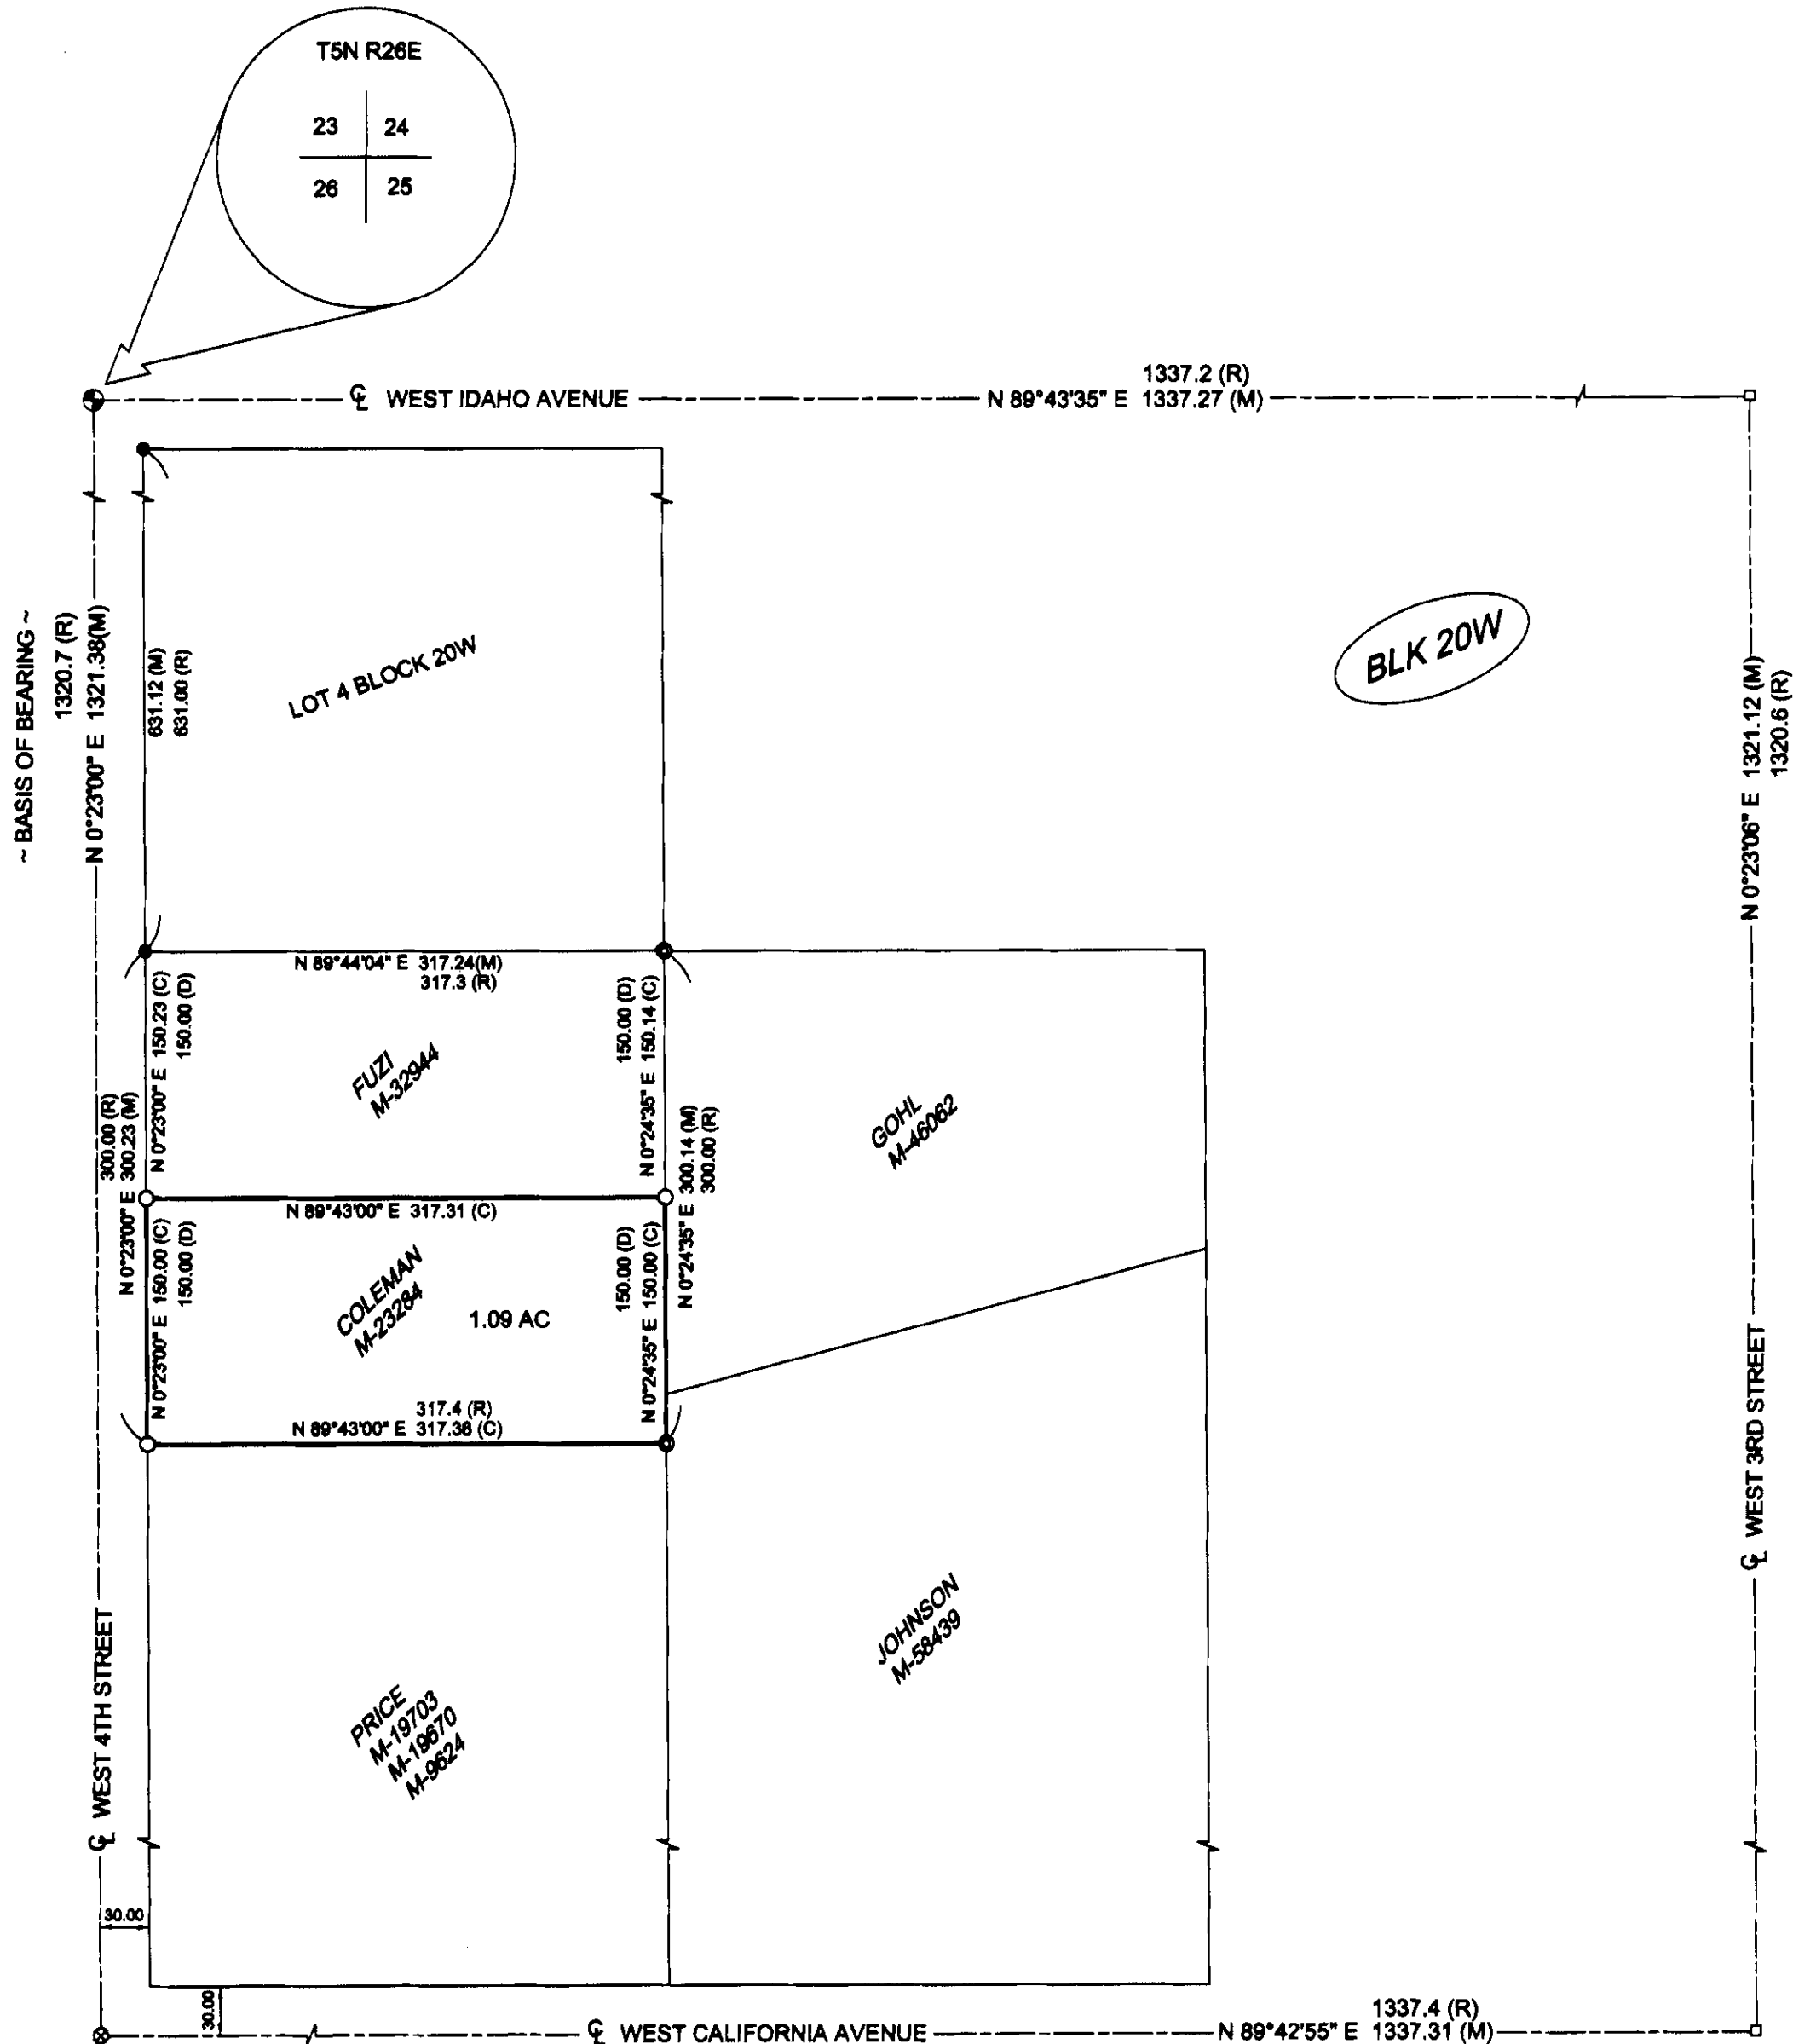

## SURVEYOR'S NARRATIVE

THIS SURVEY WAS PERFORMED AT THE REQUEST OF KAREN COLEMAN TO MONUMENT THE SOUTH 150 FEET OF THE NORTH 300 FEET OF LOT 5 BLOCK 20W.

WALTER W. CRAMER SET THE FOUR LOT CORNERS OF LOT 5 BLOCK 20W IN 1981 FOR JOHN B. COLEMAN. OF WHICH I RECOVERED THE NORTHEAST AND THE SOUTHEAST CORNERS OF SAID LOT, I ALSO RECOVERED THE NORTHWEST AND THE SOUTHWEST CORNERS OF LOT 4 BLOCK 20W SET BY TOMPKINS SURVEYING. THE FOUR BLOCK CORNERS OF BLOCK 20W WERE RECOVERED AND THE BASIS OF BEARING FOR THIS SURVEY IS THE CENTER LINE OF WEST 4TH STREET.

## SURVEYOR'S CERTIFICATION

I, BRIT L. PRIMM, A PROFESSIONAL LAND SURVEYOR IN THE STATE OF OREGON HEREBY CERTIFY THAT THIS MAP CORRECTLY REPRESENTS A SURVEY CONDUCTED UNDER MY DIRECT SUPERVISION IN MAY 2001, IN CONFORMANCE WITH THE REQUIREMENTS OF THE SURVEY RECORDING LAW, AS ESTABLISHED BY ORS CHAPTER 92.

### LEGEND

- SET 5/8" x 30" IRON ROD WITH YELLOW PLASTIC CAP STAMPED PLS LS 48509
- FOUND 5/8" IRON ROD WITH YELLOW PLASTIC CAP STAMPED TOMPKINS SURVEYING
- ⊕ FOUND 2 1/2" BRASS CAP AS SHOWN
- ⊙ FOUND 1" IRON ROD, NO CAP
- FOUND 1" PIPE, NO CAP
- FOUND 1/2" IRON ROD, NO CAP

### NOTES

- (D) DEED
- (M) MEASURED
- (C) CALCULATED
- (R) RECORD - CRAMERS SURVEY NUMBER B 491 K

### SURVEYS

CRAMER SURVEY FOR JOHN B. COLEMAN SURVEY NUMBER B 491 K

### DEEDS

- M-32944
- M-23284
- M-58439
- M-19703

REGISTERED PROFESSIONAL LAND SURVEYOR  
*BLP*  
OREGON JULY 13, 1999  
BRIT L. PRIMM  
48508  
EXPIRATION DATE: 12/31/02

DATE July 12, 2001

RECEIVED BY  
Morrow County Surveyor  
Date 08/01/01  
Rec'd By PLM  
No. 1-1315-M  
Folder No. 1315

**PRIMM LAND SURVEYING**

P.O. BOX 1322, 775 S.E. 10TH  
HERMISTON, OR 97838  
BUI (541) 584-7887  
FAX (541) 587-8020  
pls@oregontrail.net

CLIENT: <b>KAREN COLEMAN</b>	
NW 1/4, SEC 25, T5N, R26E, W.M. MORROW COUNTY, OREGON	
PROJECT: MONUMENT THE SOUTH 150 FEET OF THE NORTH 300 FEET OF LOT 5, BLOCK 20 WEST, MORROW COUNTY, OREGON.	JOB#: 0105005 DATE: 5/31/01 FB/PG: 7/57 SHEET: 1 OF 1 DRAWN BY: BLP APPROVED: BLP

1315