


LEGEND:

- 000 MEASURED, THIS SURVEY.
- 000 • DEED REFERENCE AS NOTED.
- (000) - McKINNIS FOR UNRUH AND McGUIRE, 1993.
- (000) FERGUSON FOR WILLOW CREEK PARK DIST, MORROW COUNTY, THE CITY OF HEPPNER AND MORROW COUNTY GRAIN GROWERS, 1999.
- / 000 / WAYNE HARRIS CO. FOR DIGGINS, 1976. (ED HERBES)
- (000) KRUMBEIN FOR WRIGHT 1978
- # 000 # ODOT DNG. 38-11-14, M.P. 46.35, JUNE 1952.
- SET A 5/8" X 30" STEEL REBAR WITH A PLASTIC CAP STAMPED LS 2850.
- FERGUSON FOR WILLOW CREEK PARK DIST, MORROW COUNTY, THE CITY OF HEPPNER AND MORROW COUNTY GRAIN GROWERS, 1999. SET OR REFERENCED BY FERGUSON. SEE HIS SURVEY, UNLESS NOTED OTHERWISE.
- ◁ FND. 1/2" IRON ROD HARRIS FOR DIGGINS 1976.
- ◇ FND. 5/8" IRON ROD WITH PLASTIC CAP STAMPED LS 2431. McKINNIS FOR UNRUH AND McGUIRE, 1993.
- LINE USED BY McKINNIS FOR E-W CENTER OF SECTION LINE ON HIS 1993 SURVEY FOR UNRUH AND McGUIRE.
- AS SURVEYED THIS RECORD OF SURVEY PLAT.
- AS SURVEYED BY WAYNE HARRIS 1976.
- AS SURVEYED BY McKINNIS 1993.

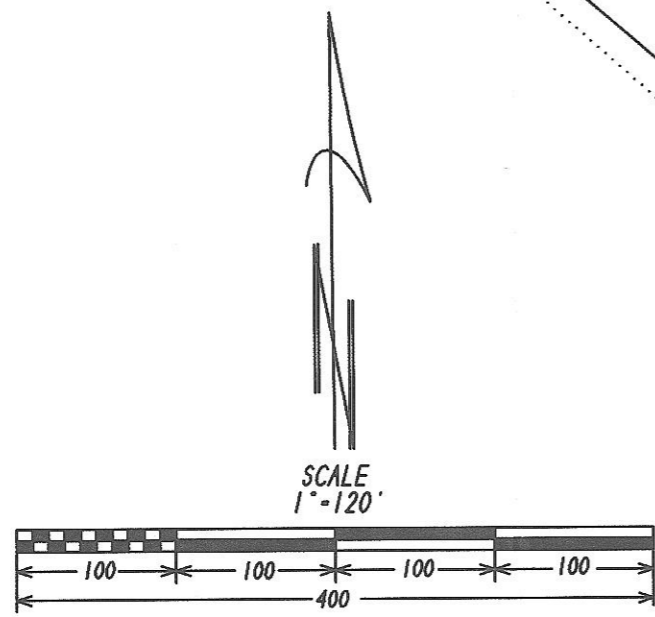

THIS SURVEY WAS PERFORMED USING 3 LOCUS SINGLE FREQUENCY STATIC RECEIVERS HAVING A STANDARD ERROR OF ± 5MM + 1 PPM TIMES THE BASE LENGTH, AND A NIKON DTM-430 TOTAL STATION HAVING STANDARD ERRORS OF ± 0'00"03" ANGULAR AND ± 3MM + 3 PPM TIMES THE DISTANCE. ALL MONUMENTS SHOWN AS FOUND WERE VISITED DURING THE COURSE OF THIS SURVEY.

DISTANCES AND BEARINGS SHOWN ARE TRUE.

REGISTERED
PROFESSIONAL
LAND SURVEYOR

Judson L. Copcock

OREGON
JANUARY 20 1998
JUDSON L. COPPOCK
2850

RENEWAL DATE: DEC. 31 2003

RECEIVED BY
Morrow County Surveyor
Date 08-03-03
Rec'd By RUM
No. C-1386-M

SURVEY FOR: HYATT, KINDLE AND CLINE JOINING EACH OTHER AND ALSO ALL JOINING THE NORTHEAST ROW OF THE 20 FOOT WIDE ALLEY ON THE NORTHEAST SIDE OF MT. VERNON ADDITION TO THE CITY OF HEPPNER, AS LOCATED IN SECTION 27, T 2 S, R 26 E, WILLAMETTE MERIDIAN, MORROW COUNTY, OREGON.

COPPOCK SURVEYING 04/03/03
P.O. BOX 495 541-676-8750
HEPPNER, OR. 97836 Job No. 0402213