

**LEGEND:**

- FOUND IRON REBARS SET BY KRUMBEIN IN 1984 & 1985 SURVEYS OF "SUNRIDGE TERRACE, PHASES 1, 2, & 3", SIZE AS NOTED.
- ⊙ SET CONC. NAIL IN SIDEWALK
- SET 5/8"X30" IRON REBAR WITH PLASTIC CAP #951
- (000) OF RECORD, "SUNRIDGE TERRACE, PHASES 1, 2, & 3",
- [000] CORRECTED RECORD--ORIGINAL PLAT WRONG


**NARRATIVE:**

THE PURPOSE OF THIS SURVEY IS TO LOCATE AND SET THE CORNERS OF LOT 10, BLOCK TWO, "SUNRIDGE TERRACE, PHASE 3", SO A MANUFACTURED HOME CAN BE SITED. I BASED THE BEARINGS ON AND USED THE PLATS OF "SUNRIDGE TERRACE" TO RETRACE THE ORIGINAL PLATS FROM 5 FOUND MONUMENTS TO ESTABLISH THE CORNERS OF SAID LOT 10. THE SOUTHWEST CORNER FALLS IN THE CONCRETE OF A CHAIN LINK FENCE POST SO WAS SET 1.5' NORTH.

REGISTERED  
PROFESSIONAL  
LAND SURVEYOR

*G. Dennis Edwards*

OREGON  
JULY 16, 1971  
G. DENNIS EDWARDS  
9 5 1  
RENEWS 12/31/2003

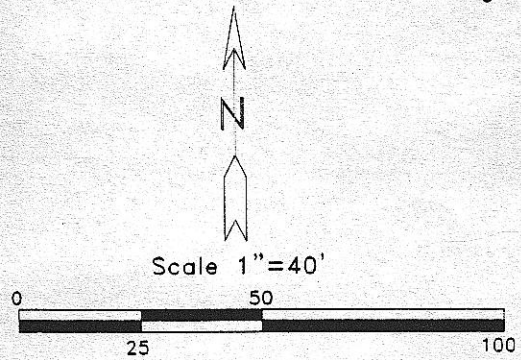

RECEIVED BY  
Morrow County Surveyor  
Date SEPTEMBER 2005  
Rec'd By SKB  
No. 1442-B

SURVEY FOR JUVENCIO AGRIPINO  
IN LOT 10, BLK. 2, "SUNRIDGE TERRACE, PHASE 3",  
IN SE 1/4, SEC. 16, T 4 N, R 25 E, WM.,  
W.M., CITY OF BOARDMAN, MORROW COUNTY, OREGON  
5/8/2003 JOB# S0305104  
EDWARDS SURVEYING P.O. BOX 763  
541-567-3336 HERMISTON, OREGON 97838  
DRAWN BY NJF