

NARRATIVE:

THE PURPOSE OF THIS SURVEY IS TO STAKE THAT TRACT OF LAND DEEDED TO ARCHIE AND RUBY BARCLAY RECORDED ON M-2003-8277 MORROW COUNTY DEED RECORDS. SAID DEED CONTAINS TWO DESCRIPTIONS, ONE EACH IN TWO PARAGRAPHS IN EXHIBIT "A". FROM THE ZONING MAP WHICH I GOT FROM THE CITY OF IRRIGON IT LOOKS LIKE EACH PARAGRAPH IS MEANT TO DESCRIBE PROPERTY IN DIFFERENT ZONES SO I STAKED THEM SEPARATELY. IT LOOKS LIKE MOST OF TAX LOT 2636 LIES IN A COMMERCIAL ZONE AND ALL OF TAX LOT 2605 LIES IN A RESIDENTIAL ZONE.

I BASED THIS SURVEY ON ONES I DID FOR GROW, ET AL, IN 1996 AND FOR BARCLAY IN 1997 IN WHICH I ESTABLISHED THE CORNERS OF BLOCK 43. THE BEARINGS ARE TRUE BASED ON W.G.S. 1984 ESTABLISHED WITH TRIMBELL G.P.S.


REGISTERED
PROFESSIONAL
LAND SURVEYOR

G. Dennis Edwards

OREGON
JULY 16, 1971
G. DENNIS EDWARDS
9 5 1
RENEWS 12/31/2003


LEGEND

- MONUMENTS FOUND AS NOTED
- SET 5/8"X30" IRON REBAR WITH PLASTIC CAP #951
- ⊙ COMPUTED LOCATION
- (000) OF RECORD, MY 1996 SURVEY FOR GROW & MY 1997 SURVEY FOR BARCLAY
- [000] OF RECORD, PLAT OF "TOWN OF IRRIGON"

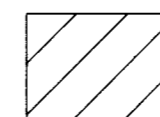

AREA BELIEVED TO BELONG TO KEN ANDERSON, (TAX LOT 2639)

RECEIVED BY
Morrow County Surveyor
Date SEPT 2005
Rec'd By SKB
No. 1445-C

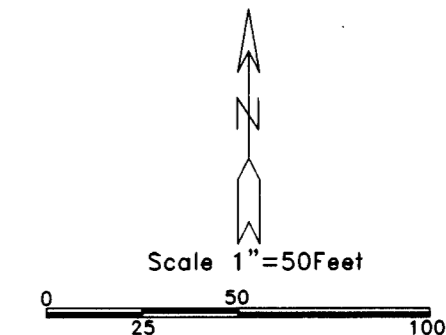

SURVEY FOR ARCHIE BARCLAY
IN BLK. 43, "TOWN OF IRRIGON", IN SW 1/4, SEC. 19,
T 5 N, R 27 E, W.M., MORROW COUNTY, OREGON
8/14/2003 JOB# S0308210
EDWARDS SURVEYING P.O. BOX 763
541-567-3336 HERMISTON, OREGON 97838
DRAWN BY NJF

1445