


LEGEND:


- MONUMENTS FOUND AS NOTED
- FENCE POST AS NOTED
- ⊙ COMPUTED LOCATION

(000) OF RECORD MY 1984 SURVEY FOR BATES
 NOTE: Morrow County Court vacated by court order
 "BIRCH LAKE ACRES" on Nov. 2, 1977, M-12487.

John A. Lyman
 Morrow Co. Surveyor

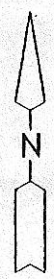

SCALE: 1" = 40'

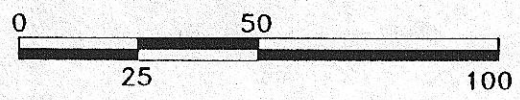

0.67 AC

REGISTERED
 PROFESSIONAL
 LAND SURVEYOR

G. Dennis Edwards

OREGON
 JULY 16, 1971
 G. DENNIS EDWARDS
 9 5 1
 RENEWS 12/31/2007

RECEIVED BY
 Morrow County Surveyor
 Date MAY 3, 2006
 Rec'd By SKB
 No. 1465-B

ABANDONED
 R.R. R/W

0.17 AC

US HWY #730

MAP FOR GERALD KINGERY
 IN NE 1/4, SEC. 21, T 5 N, R 27 E,
 W.M., MORROW COUNTY, OREGON
 02/28/2006 JOB# S0602034
 EDWARDS SURVEYING P.O. BOX 763
 541-567-3336 HERMISTON, OR 97838
 DRAWN BY JMC