

T5N  
T4N

T5N  
T4N

FND. 2 1/2" B.C.  
SET IN PLACE OF  
BENT 1939 GOULD SUR.

CO. RD. 930, 911  
50' R/W  
JOURNAL H - 521  
JULY 6, 1955  
DEED FROM S. POULSON  
25' JULY 19, 1955


PETITION # 432 CO. RD. 904 & (930)  
40' R/W  
JOURNAL G - 282, 298  
DEC. 8, 1932

PETITION # 389 CO. RD. 908 & 816  
40' R/W  
JOURNAL F - 305, 311, 323, 328, 330, 331  
JUNE 7, 1922  
REDUCED WIDTH TO 40' FROM 60'

PETITION # 375 CO. RD. 761  
40' R/W  
JOURNAL F - 165, 166, 173, 176  
OCT. 1, 1919

**NARRATIVE:**

THE PURPOSE OF THIS SURVEY IS TO STAKE THE RIGHT OF WAY OF DEPOT LANE FROM PATERSON FERRY ROAD TO WAGON WHEEL LOOP SO UMATILLA ELECTRIC COOP CAN STAKE A NEW POLE LINE ON THE COUNTY EASEMENT OR RIGHT OF WAY.  
I BASED THE BEARINGS ON GOULDS 1939 DEPENDENT RESURVEY OF T 4 N, R 26 E.

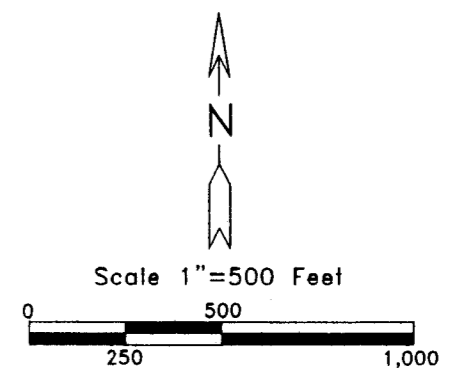

REGISTERED  
PROFESSIONAL  
LAND SURVEYOR  
*G. Dennis Edwards*  
OREGON  
JULY 16, 1971  
G. DENNIS EDWARDS  
RENEWS 12/31/2007

- LEGEND:**
- MONUMENTS FOUND AS NOTED
  - △ SET R.R. SPIKE
  - SET PK NAIL
  - POWER POLE
  - SET WOOD HUB
  - SET MONUMENTS AS NOTED
  - [000] OF RECORD, GOULD 1939 DEPENDENT RESURVEY

RECEIVED BY  
Morrow County Surveyor  
Date May 3, 2006  
Rec'd By SKB  
1466-D

SURVEY FOR UMATILLA ELECTRIC COOPERATIVE  
IN SECS. 1, 2, & 3, T 4 N, R 26 E, & SECS. 34,  
35, & 36, T 5 N, R 26 E, W.M., MORROW CO., ORE.  
03/07/2006 JOB# S0602025  
EDWARDS SURVEYING P.O. BOX 763  
541-567-3336 HERMISTON, OREGON 97838  
DRAWN BY JMC