


LEGEND:

- SET A 5/8" X 30" STEEL REBAR WITH A PLASTIC CAP STAMPED LS 2850
- MONUMENTS FOUND AS NOTED
- ⊕ CENTER OF SECTION 11, TOWNSHIP 4 SOUTH RANGE 28 EAST OF THE WILLAMETTE MERIDIAN.
- 000 D DEED RECORDED AT 2006-16282
- (000) DEED RECORDED AT M-22504
- (000) DEED RECORDED AT M-10226

FND. 1/2" GALV. PIPE HELD FOR THIS SURVEY.

FND. 1/2" REBAR. TOLD BY LOCALS THAT THIS MONUMENT HAD BEEN MOVED TWICE. ONCE WEST TO FENCE LINE NEXT TO ROAD AND THEN BACK EAST TO WHERE MR. BLAKE THOUGHT IT SHOULD BE.

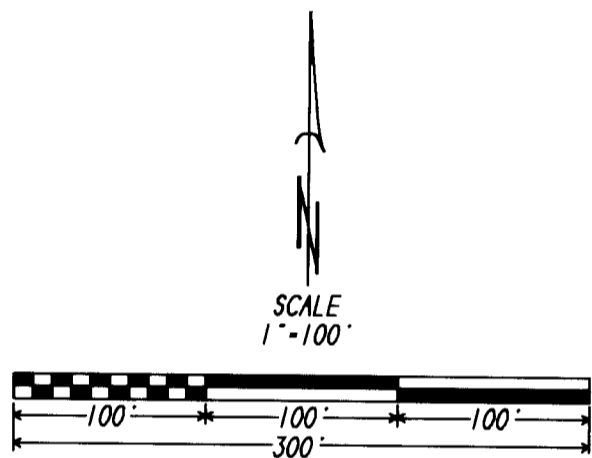


SURVEYORS NARRATIVE:

THE PURPOSE OF THIS SURVEY IS TO LOCATE AND MONUMENT THE CORNERS OF THAT TRACT OF LAND DESCRIBED IN A WARRANTY DEED RECORDED AS DOCUMENT NUMBER 2006-16282 IN THE MORROW COUNTY, OREGON DEED RECORDS.

I HELD THE MONUMENTS SHOWN AS HELD ON THE DRAWING TO ESTABLISH AN AREA WITH SOME AGREEMENT TO THE RECORD AND OCCUPATION. THE TRACT WAS THEN SURVEYED AND MONUMENTED HOLDING THE NORTH-SOUTH CALLS WITHIN THE HELD MONUMENTS AND A PARALLEL LINE ALONG THE WEST AS CALLED FOR IN THE DESCRIPTIONS.

EAST 550.00' D
(WEST 550 FEET)
N 90°00'00"E 541.83'

WHITE TRACT
WARRANTY DEED RECORDED AS DOCUMENT NUMBER 2006-16282 MORROW COUNTY, OREGON DEED RECORDS.

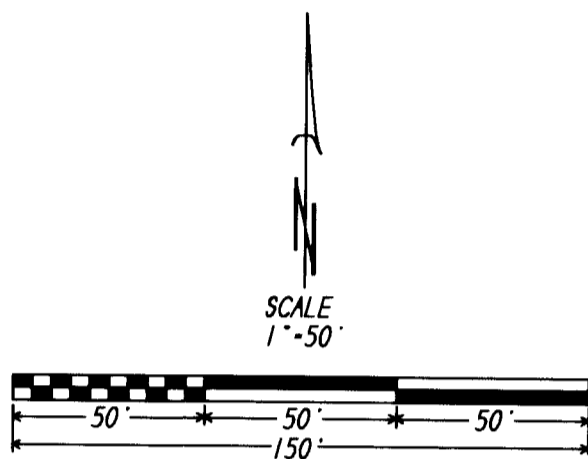

| CURVE | BEARING | HORIZ DIST | RADIUS | ARC | DELTA | TANGENT |
|-------|-------------|------------|---------|---------|-----------|---------|
| C1 | S30°49'13"W | 77.61' | 159.98' | 78.39' | 28°04'34" | 40.00' |
| C2 | S73°40'47"W | 96.90' | 100.50' | 101.11' | 57°38'33" | 55.30' |
| C3 | N34°04'32"W | 94.38' | 68.65' | 104.06' | 86°50'49" | 64.97' |

CENTER OF SECTION 11, T 4 S, R 28 E, W.M. FND. 1" GALV. PIPE WITH THE TOP BEAT UP FROM DRIVING INTO GRD. HELD FOR THIS SURVEY.

REGISTERED PROFESSIONAL LAND SURVEYOR

John A. Coppock

OREGON
JANUARY 20 1998
JUDSON L. COPPOCK
2850

RENEWAL DATE: DEC. 31, 2007

THIS SURVEY WAS PERFORMED USING A NIKON DTM-430 TOTAL STATION HAVING STANDARD ERRORS OF +/- 00°00'03" ANGULAR AND +/- 3MM + 3 PPM TIMES THE DISTANCE. ALL MONUMENTS SHOWN AS FOUND WERE VISITED DURING THE COURSE OF THIS SURVEY.

ALL BEARINGS SHOWN ARE BASED UPON THE RECORD BEARING OF EAST ALONG THE EAST-WEST CENTERLINE OF SECTION AS NOTED IN DEED TAYLOR TO DEVIN AND RECORDED AS DOCUMENT M-10226 MORROW COUNTY DEED RECORDS.

RECEIVED BY

Morrow County Surveyor
Date APR 27 2007
Rec'd By SKB
No. 1500-C

BOUNDARY SURVEY FOR:
STEPHEN P. AND BILLIE ANN WHITE
4033 SE LENORE CIRCLE
TROUDALE, OR 97060

COPPOCK SURVEYING 27 APRIL 2007
P.O. BOX 495 541-676-8750
HEPPNER, OR 97836 FAX 676-8753
Job No. 0506374