


This portion of a map was obtained by Mr. Judson Coppock from Mr. Tom McElligott of Morrow County Title and Abstract who had the original in his records. Mr. Coppock reported the original map showed that it was done by Mr. Verl Fraley for a Mr. Ed LaTrace in 1965.

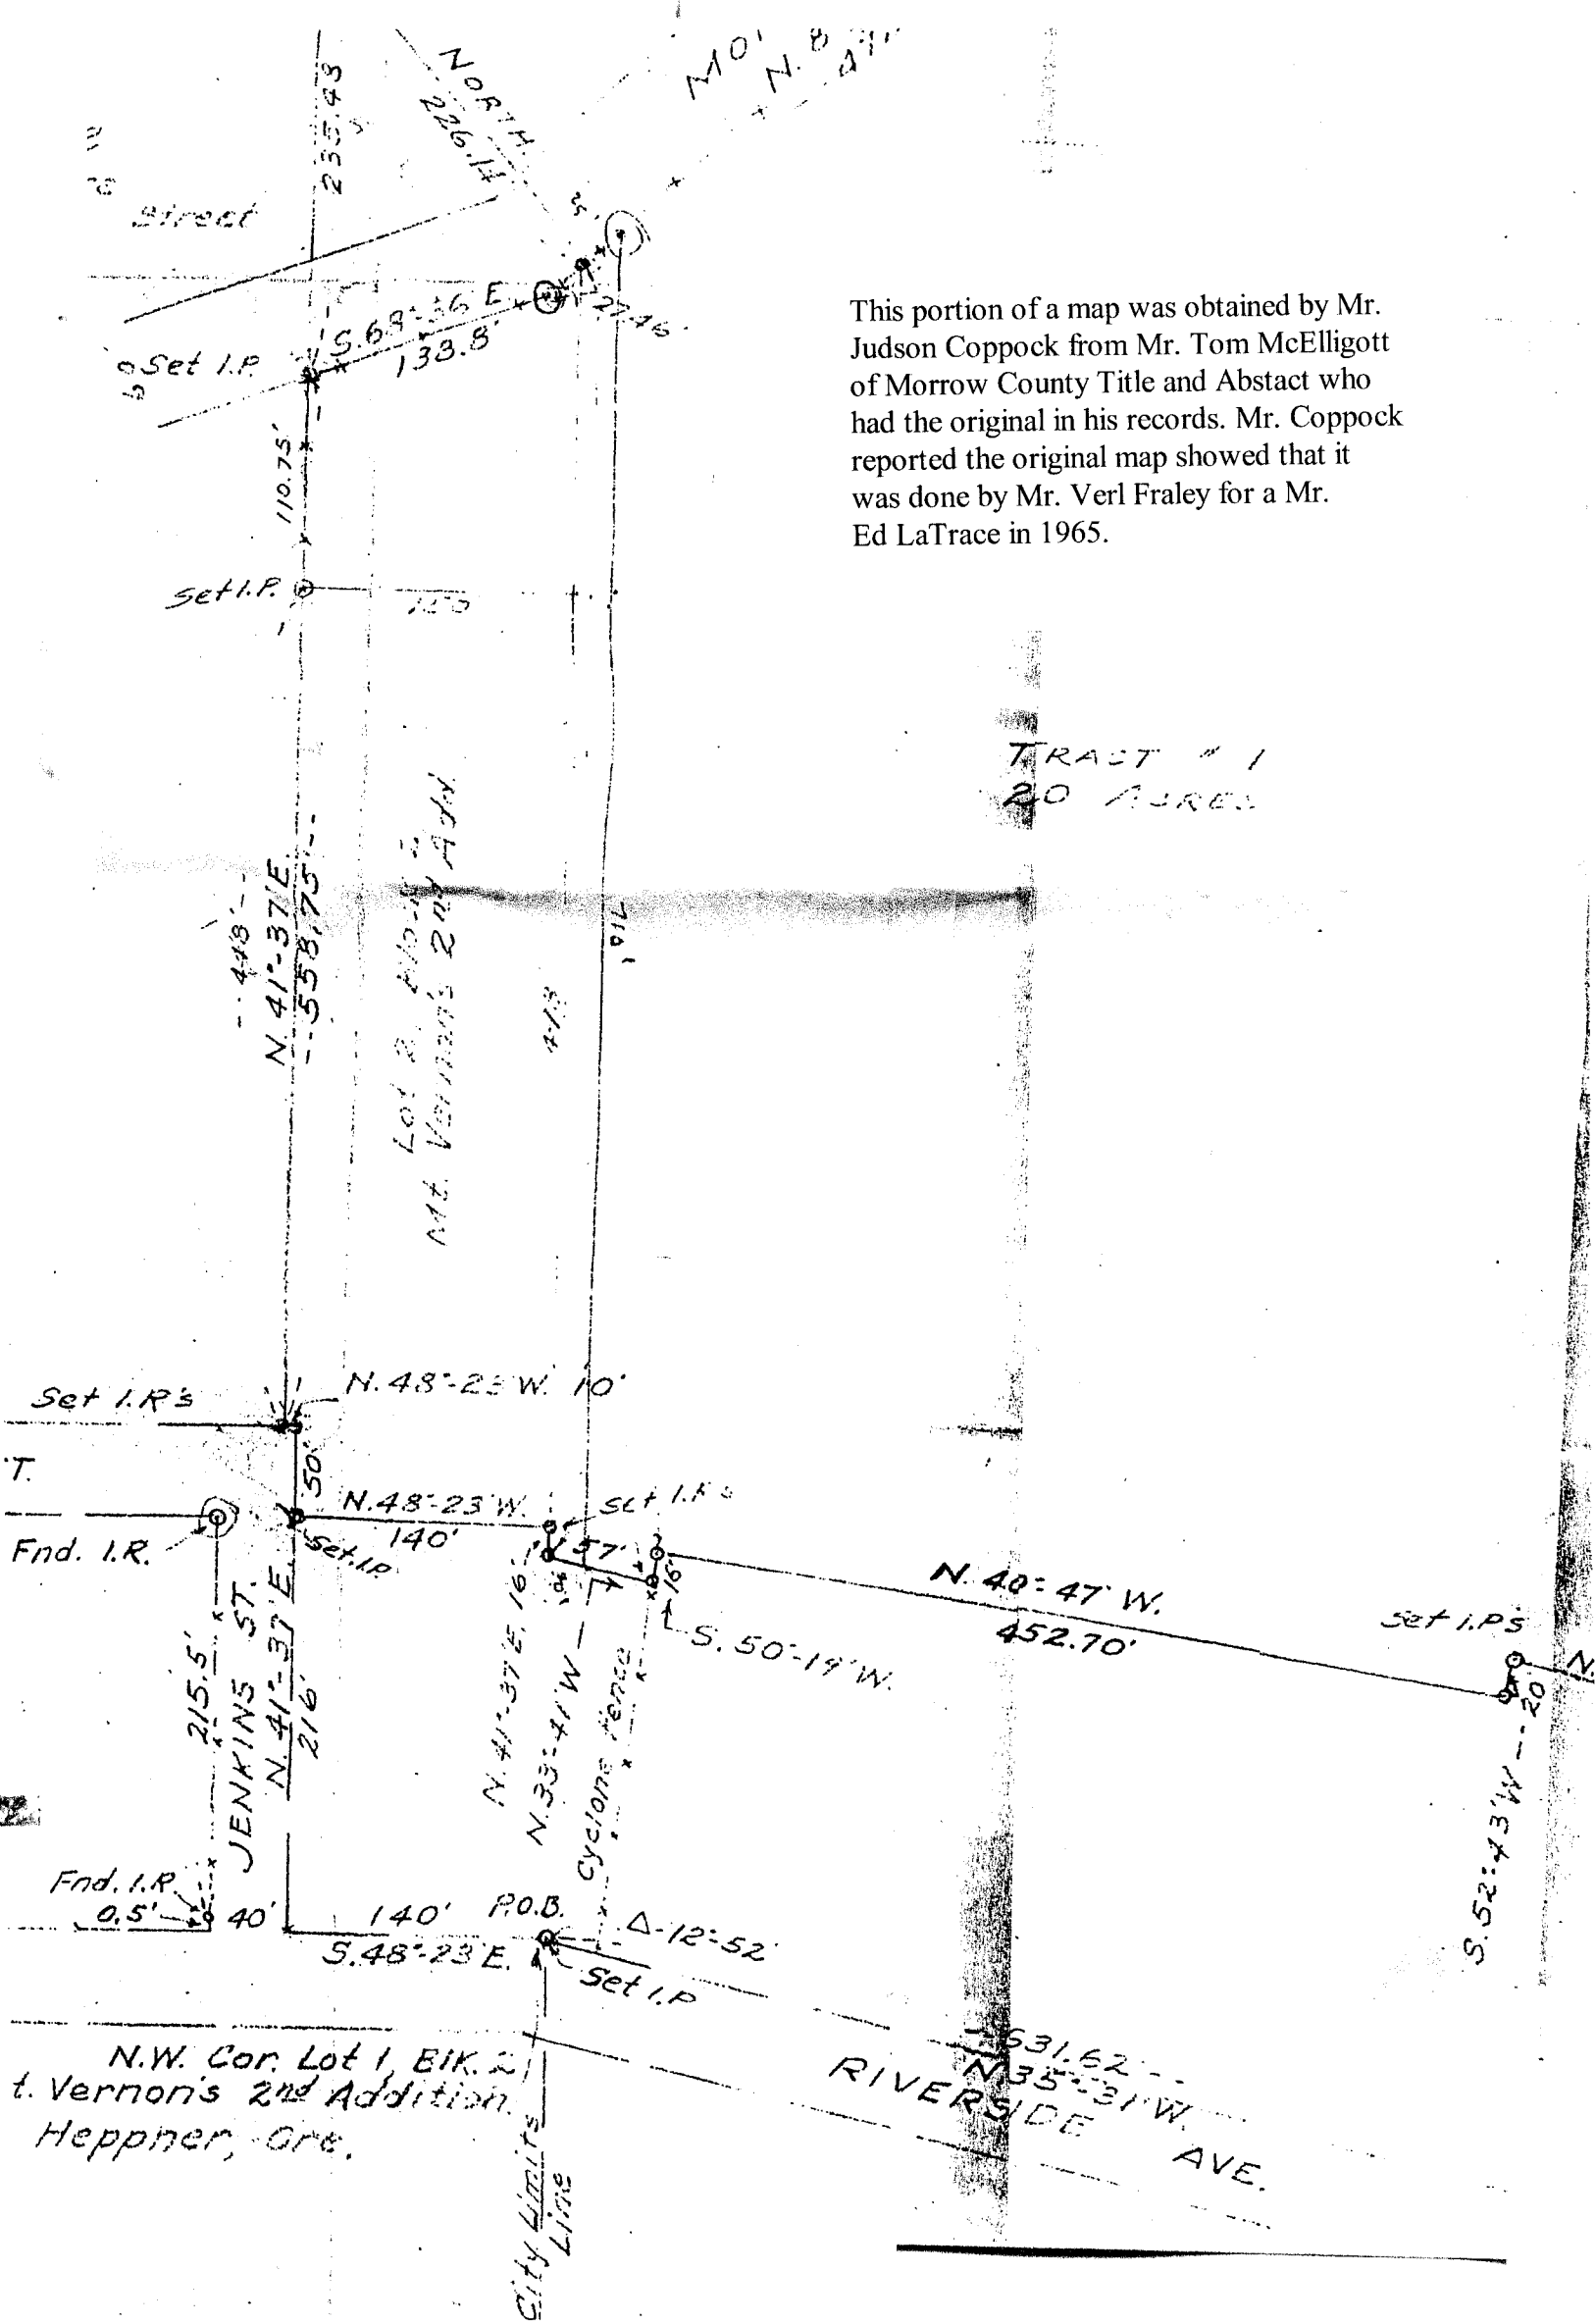

RECEIVED BY

Morrow County Surveyor

Date: 2-19-2015

Rec'd By: S.K.H.

No.: 2015-1726C

Folder No.: 1726