


1734

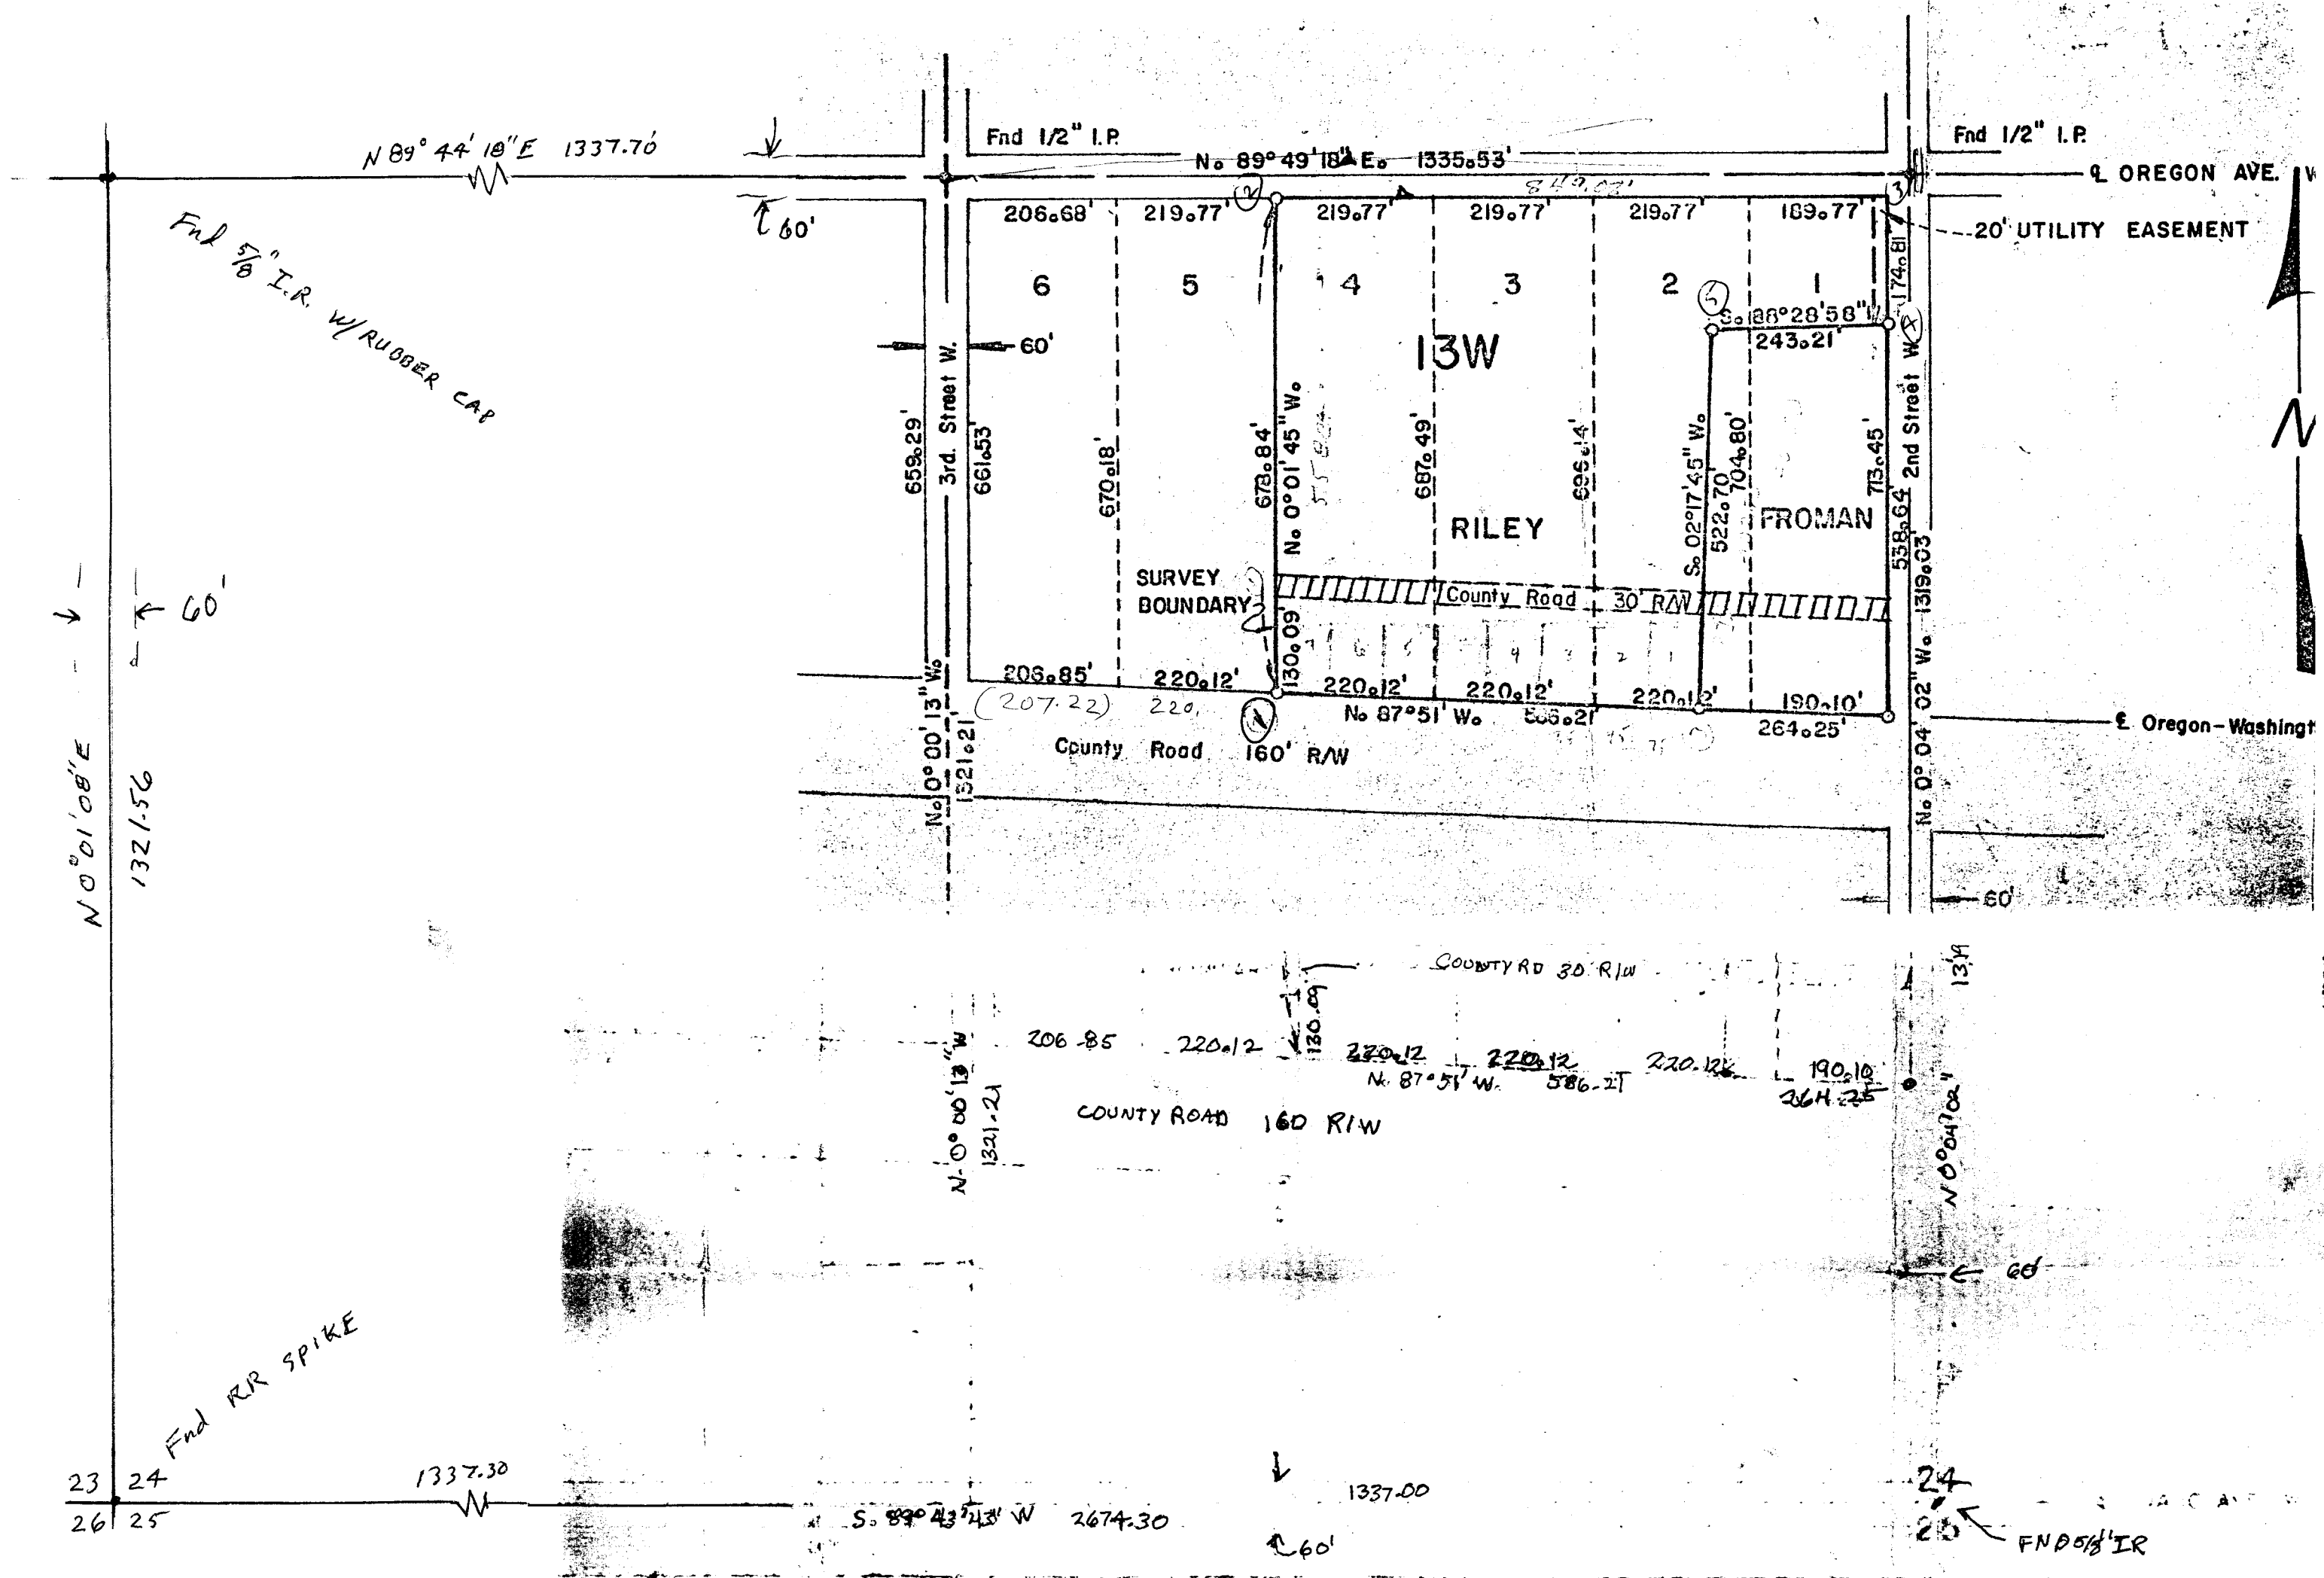

3 1/4, 1 W 1/4, Sec. 24, T.5N, R.20E, W.M.

RECEIVED BY
 Morrow County Surveyor
 Date: 5-5-15
 Rec'd By: S.K.H.
 No.: 2015-1734C
 Folder No.: 1734



SURVEY FOR
CARL RILEY & DICK FROMAN
 1120 N. 1st St.
 ASTORIA, OREGON 97103

1734