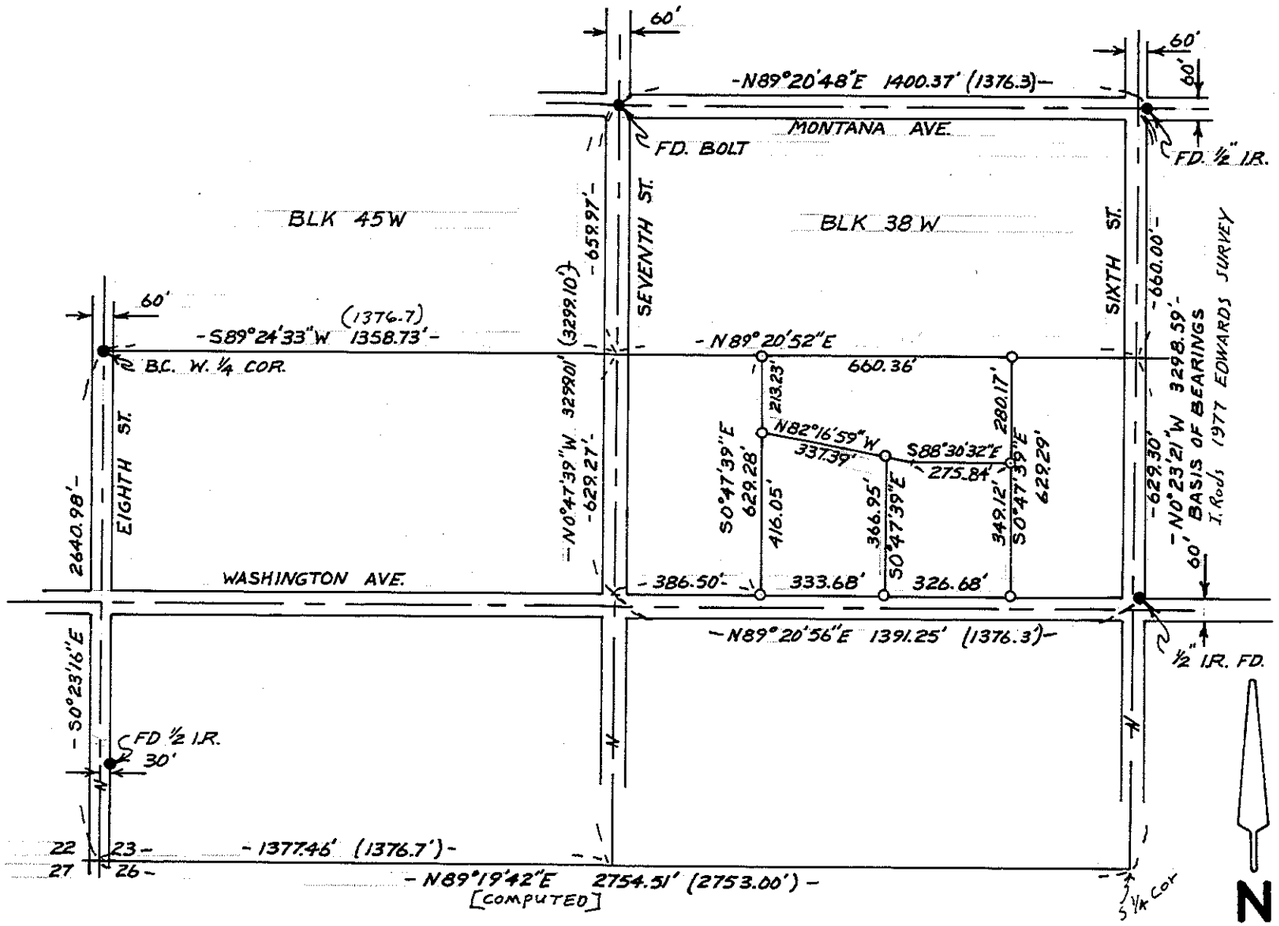

SURVEY FOR GORDON NELSON

LOCATION S.W. ¼ OR Block 38 WEST

SEC. 23, T 5 N, R 26 E, W.M., MORROW COUNTY, OREGON

DATE 8-15-78 SCALE: 1" = 400'

- MONUMENTS FOUND (000) OF RECORD
- o IRON RODS SET ½" JOB NO. S7808296

EDWARDS SURVEYING
567-3336

P. O. Box 763
Hermiston, Ore.

REGISTERED PROFESSIONAL LAND SURVEYOR

G. Dennis Edwards

OREGON
JULY 15, 1971
G. DENNIS EDWARDS
951

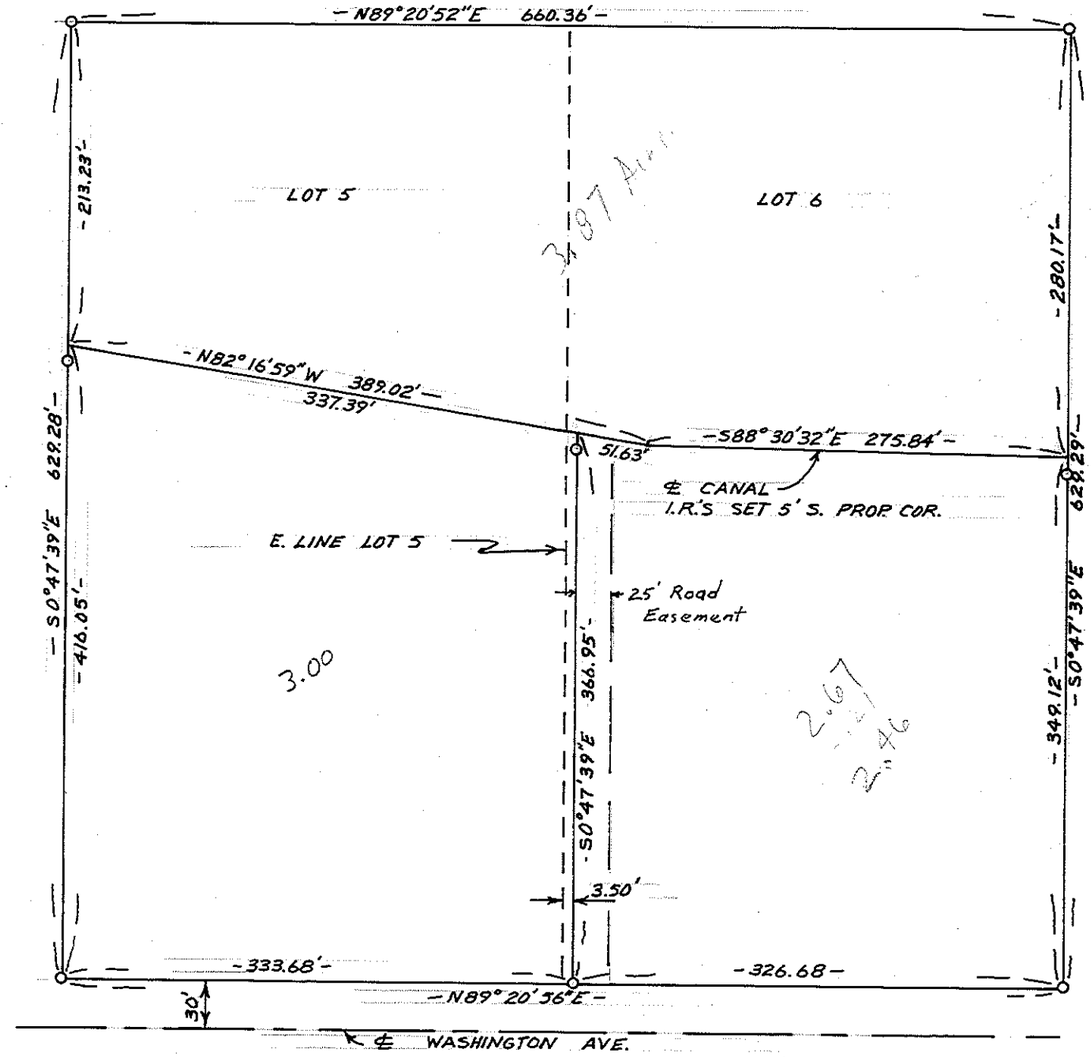

BLOWUP
SCALE: 1"=100'

RECEIVED BY
Morrow County Surveyor
Date: 2-20-2017
Rec'd By: S.K.H.
No.: 2017-1788B
Folder No.: 1788