


SAFETY PAYS


Table with columns: Station Name, Oregon State Plane Coord. System (Northing, Easting), Grid Bearing & Distance (feet), and Comments. Lists data for stations 106-108 through 110-1A.

Table with columns: STATION NAME, COORDINATES (NORTHING, EASTING), and GRID BEARING AND DISTANCE (FEET). Lists data for stations 112-108-1 BC through 112-11-110-2 BC.

Table with columns: Station Name, Oregon State Plane Coord. System (Northing, Easting), Grid Bearing & Distance (feet), and Comments. Lists data for stations 108-1-8 through 114-3.

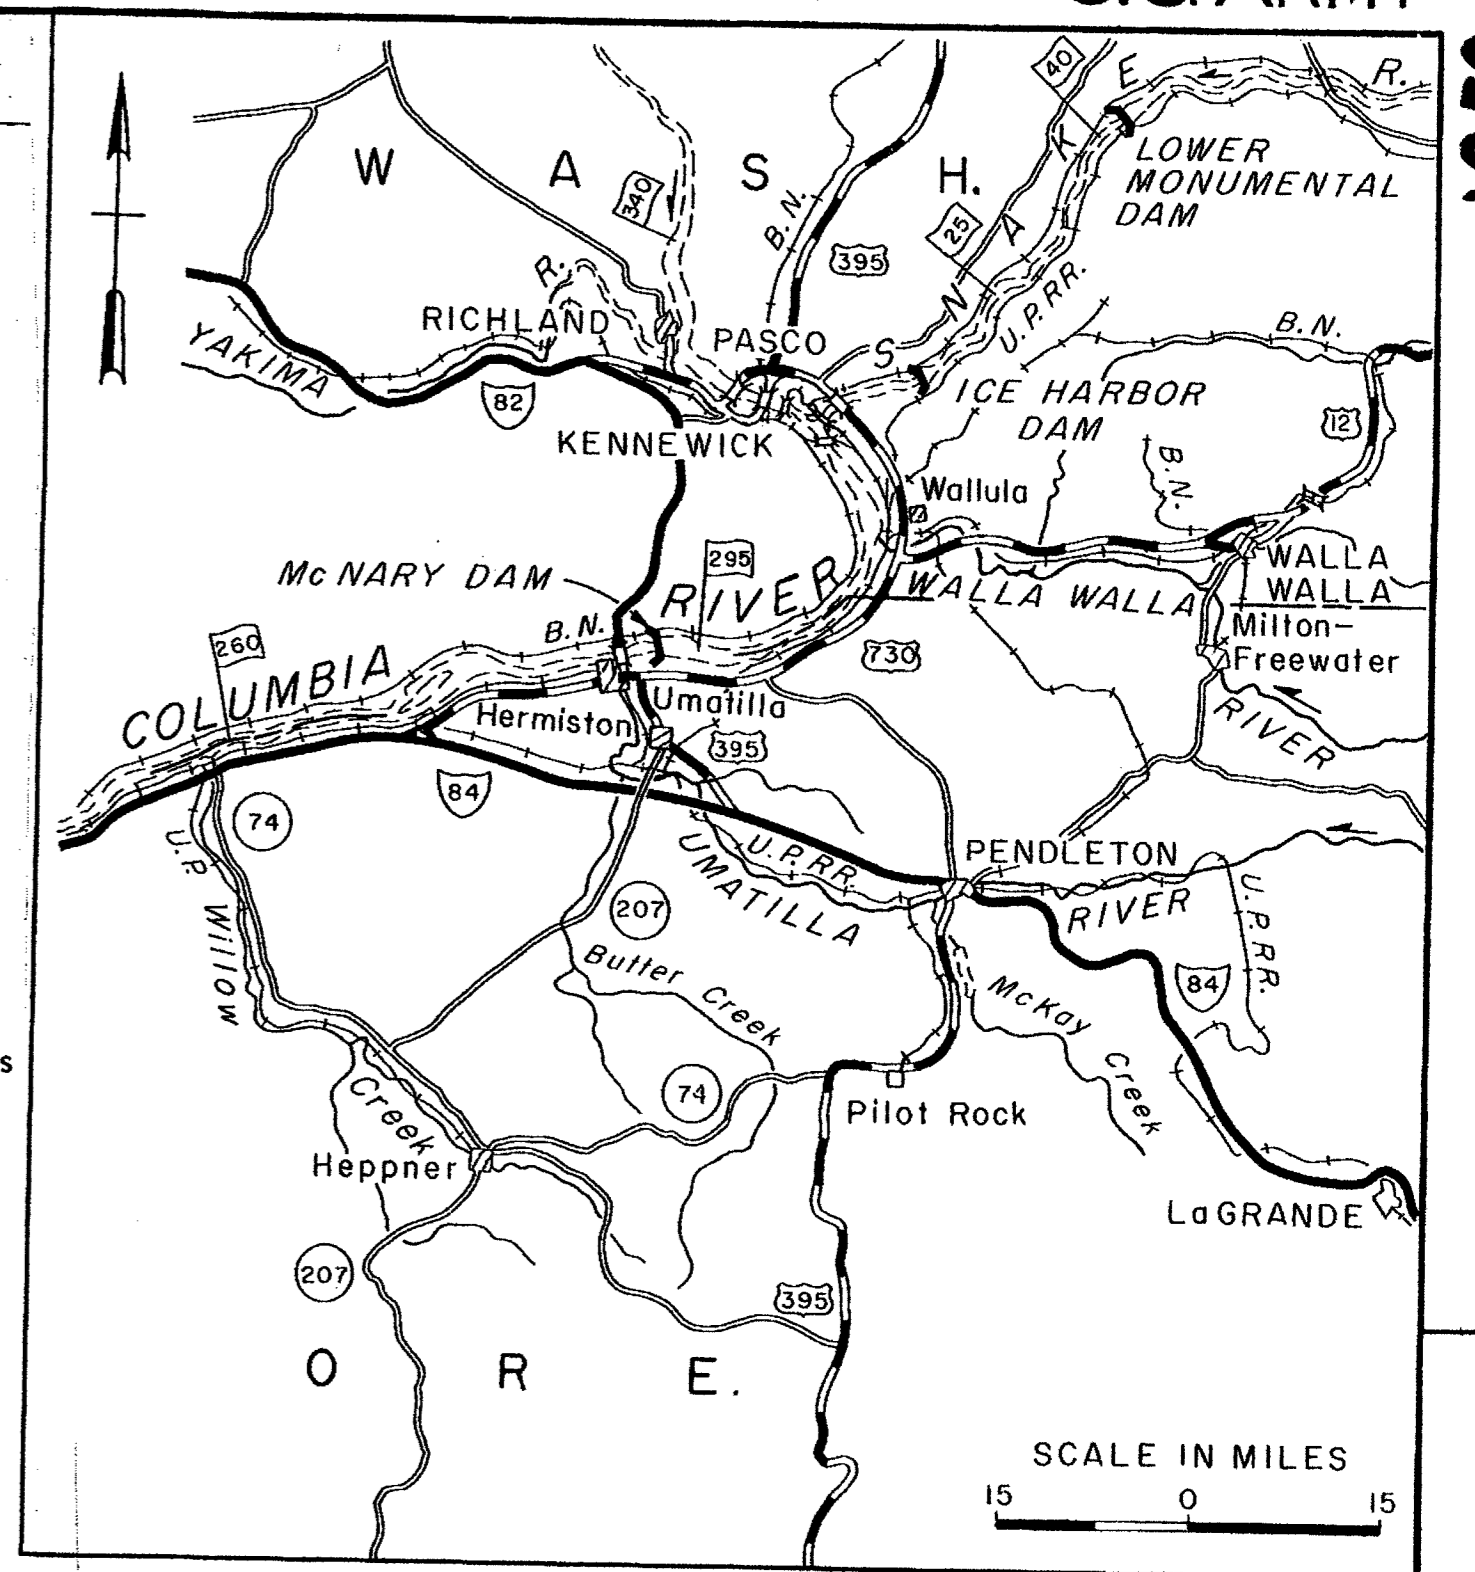

NARRATIVE: The purpose of this survey map is to depict and record the establishment and location of the Project Boundary of Willow Creek Lake, located in T.2S. R.26E and 27 E., Willamette Meridian, Morrow County, Oregon.

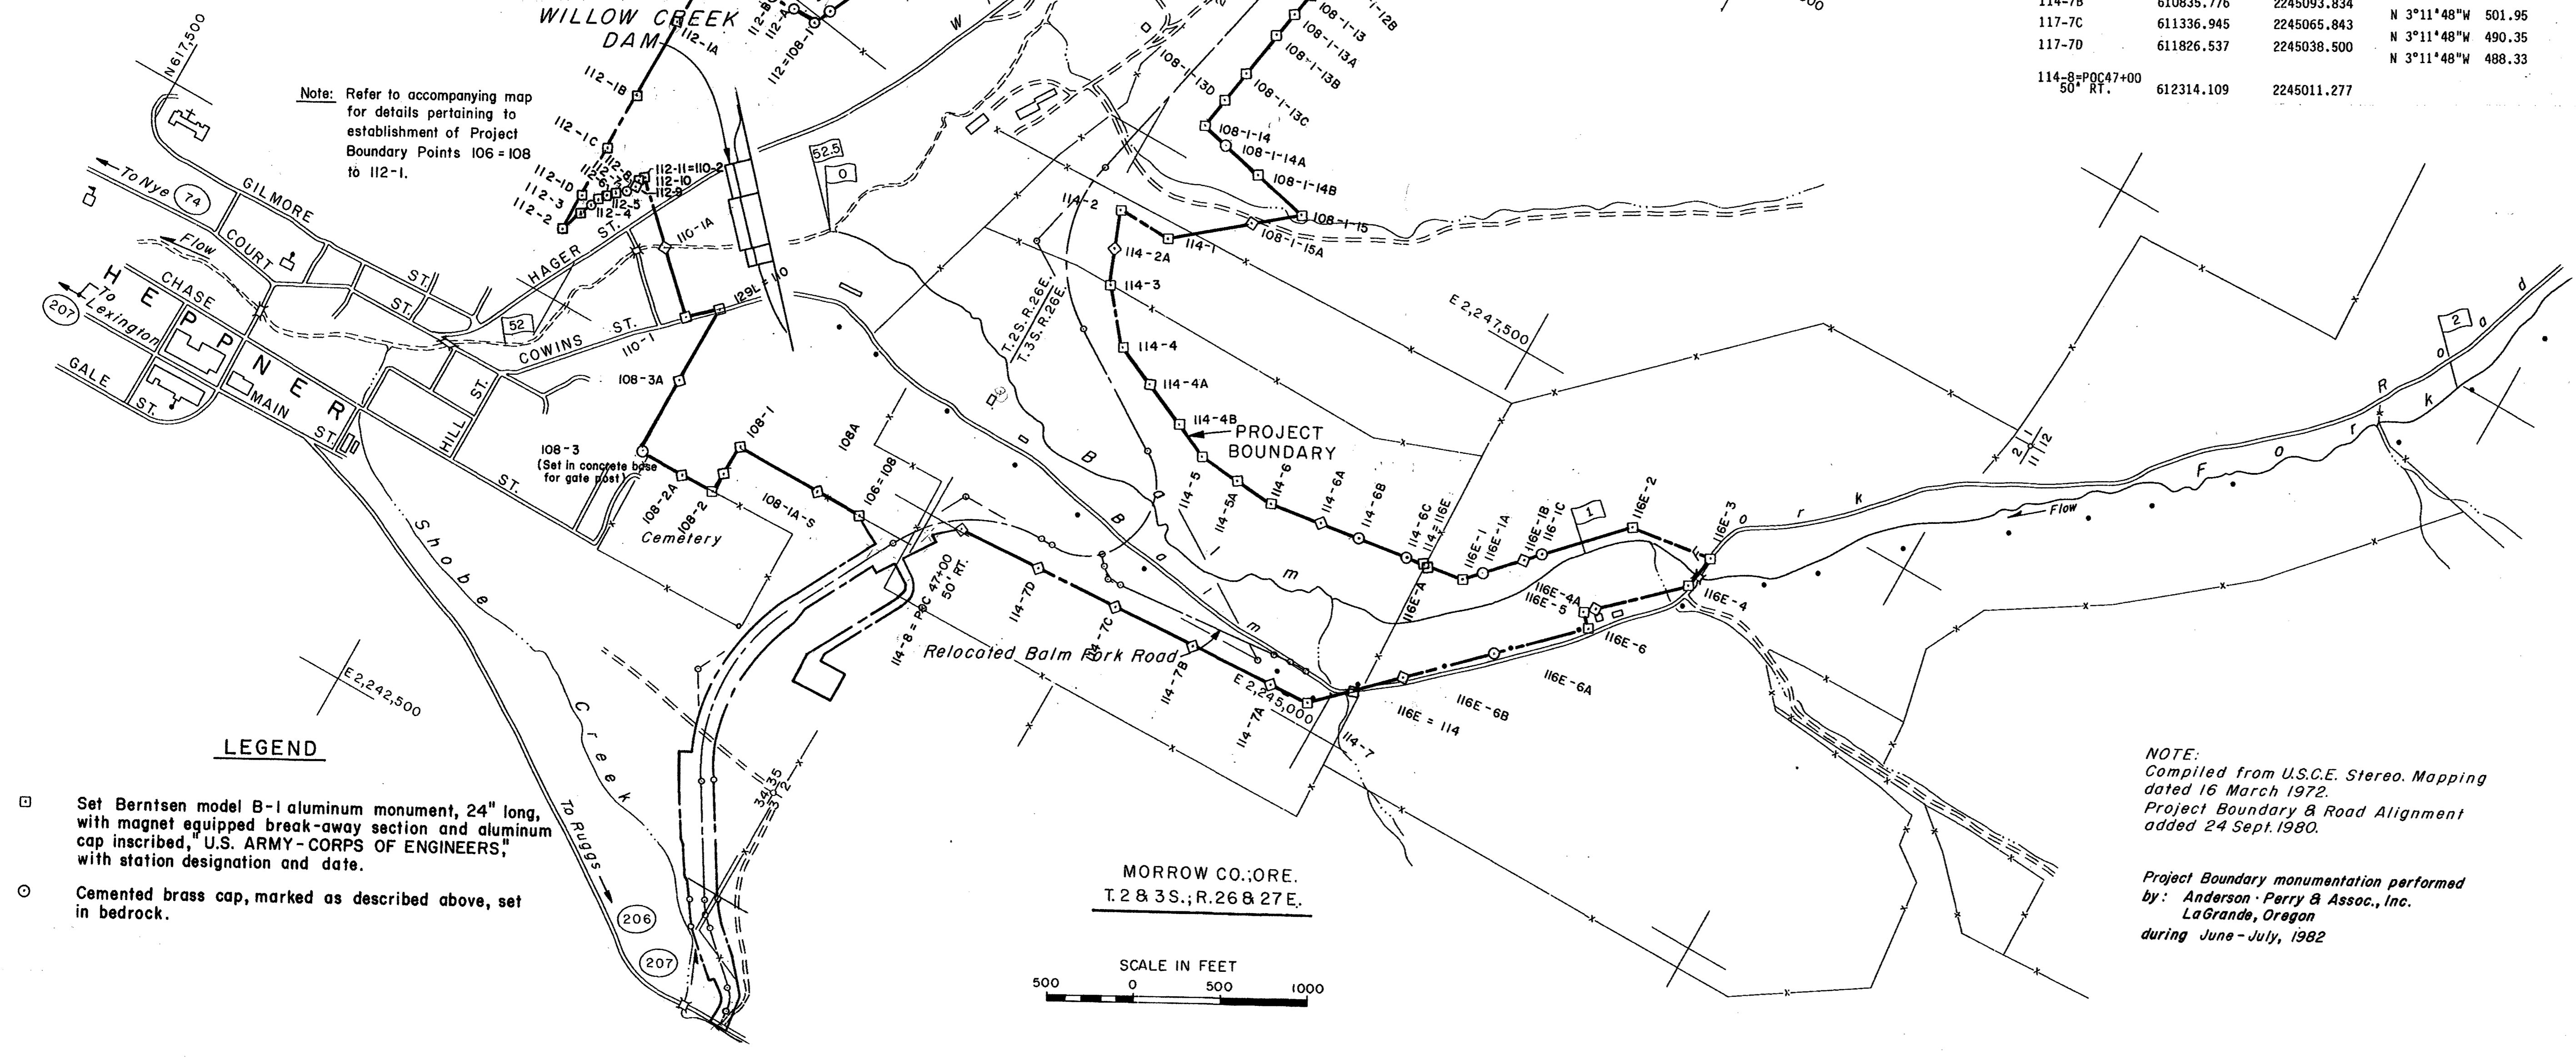

Section Corners table with columns: Section Number, Township and Range, Northing, Easting, and Distance. Lists corner locations for sections 1/4, 3/4, and 26E.

Form for U.S. Army Engineer District Walla Walla, Washington, Monumented Project Boundary. Includes fields for Designer, Drawer, Checker, Supervisor, and Chief Survey Sec, along with a revision table and date stamp.

VALUE ENGINEERING PAYS