
SURVEY NOTES

- #1: 1" SQUARE BAR PROTRUDING ABOVE GROUND AND LEANING. MEASURED AT THE POINT OF ENTRY INTO THE GROUND. THIS IS BELIEVED TO BE THE BOUNDARY MARKER ACCORDING TO MILLER.

 MAPPED HEREON FOR REFERENCE BUT NOT HELD IN THIS SURVEY. BEARS S 00°46'53" E, 9.18 FEET FROM THE TRUE CORNER LOCATION.
- #2: LARGE ROCK NEAR THE BASE OF THE NORTH-SOUTH GRAPEVINE END POST. MILLER CALLS THIS THE "BLUE ROCK". THIS IS BELIEVED TO BE THE BOUNDARY MARKER ACCORDING TO MILLER.
 MAPPED HEREON FOR REFERENCE BUT NOT HELD IN THIS SURVEY. BEARS S 31°49'24" W, 11.81 FEET FROM THE TRUE CORNER LOCATION.

RECORD OF SURVEY

LOCATED IN THE NW1/4 SE1/4 OF SECTION 25, TOWNSHIP 5 NORTH, RANGE 26 EAST, W.M., MORROW COUNTY, OR

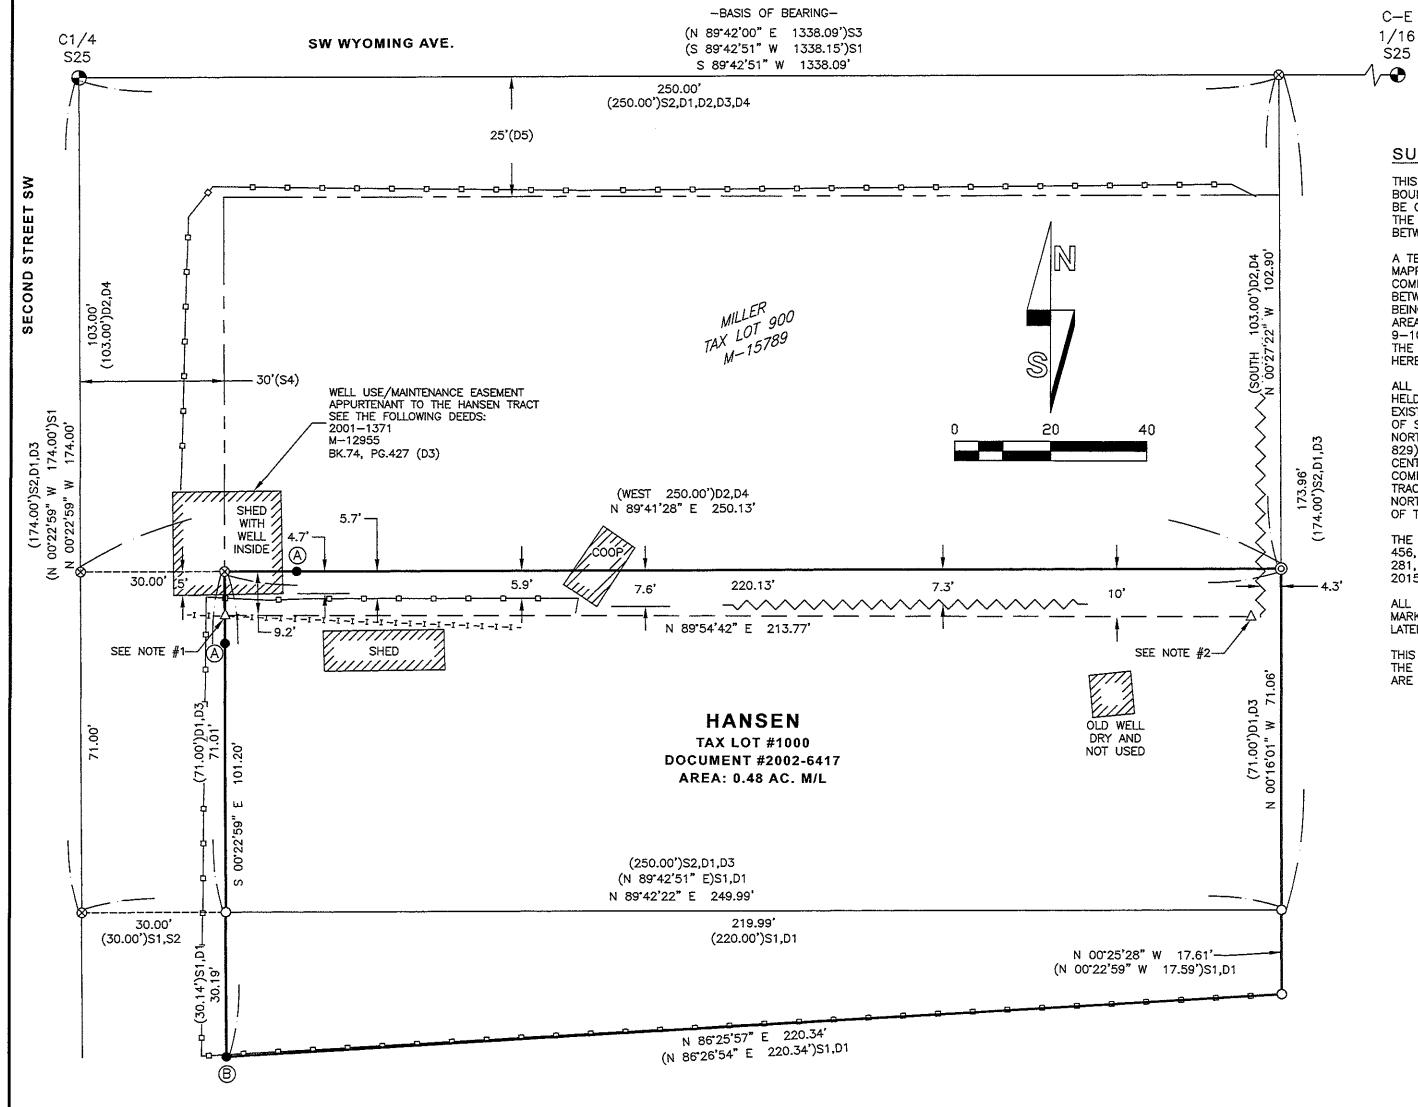

SURVEY NARRATIVE

THIS SURVEY IS BEING PREPARED AT THE REQUEST OF ALFRED HANSEN. THE PURPOSE IS TO MARK THE BOUNDARIES OF THAT TRACT DESCRIBED UNDER DOCUMENT NUMBER 2002—6417 SO THAT A FENCE LINE CAN BE CONSTRUCTED. DETERMINING THE COMMON BOUNDARY LINE BETWEEN THE HANSEN AND MILLER TRACTS IS THE PRIMARY GOAL OF THIS SURVEY AS THIS LINE IS CURRENTLY THE SUBJECT OF A BOUNDARY DISPUTE BETWEEN BOTH PARTIES.

A TEMPORARY FENCE WAS RECENTLY CONSTRUCTED BY MILLER BETWEEN THE SHED AND CHICKEN COOP AS MAPPED HEREON. HANSEN BELIEVED THE FENCE WAS ENCROACHING ON HIS LAND AT WHICH TIME HE COMMISSIONED THIS SURVEY. TESTIMONY FROM MILLER INDICATED THEY BELIEVE THE BOUNDARY IS LOCATED BETWEEN POINTS FURTHER DESCRIBED IN SURVEY NOTES #1-2, WITH ALL GRAPE VINES AND OUTBUILDINGS BEING LOCATED ON THEIR PROPERTY. AFTER CONSIDERATION OF ALL TESTIMONY AND CAREFUL ANALYSIS OF AREA SURVEY MONUMENTATION AND DEED RESEARCH/HISTORY I DETERMINE THE BOUNDARY TO BE BETWEEN 9-10 FEET NORTHERLY OF THE LOCATION AS DESCRIBED BY MILLER. ALL POSSIBLE ENCROACHMENTS ONTO THE HANSEN TRACT HAVE BEEN NOTED HEREON. THE DETAILS OF THE BOUNDARY RESOLUTION AS MAPPED HEREON ARE FURTHER DESCRIBED BELOW.

ALL FOUND SURVEY MONUMENTATION REPORTED HEREON AND FURTHER DESCRIBED IN THE LEGEND HAS BEEN HELD FOR BOUNDARY DETERMINATION. THE NORTHWEST CORNER OF THE HANSEN TRACT FALLS INSIDE AN EXISTING SHED BELONGING TO MILLER. THIS CORNER WAS COMPUTED BY HOLDING THE CENTER 1/4 CORNER OF SECTION 25 AND THE SOUTHWEST CORNER OF THE HANSEN TRACT, BEING 30.00 FEET EASTERLY OF THE NORTH—SOUTH CENTERLINE OF SECTION 25 AS SHOWN ON THE PLAT OF GREEN GARDEN ESTATES (FOLDER 829), AND APPLYING RECORD DEED DISTANCE OF 103.00 FEET SOUTHERLY ALONG THE NORTH—SOUTH CENTERLINE OF SECTION 25. I THEN ESTABLISH THE NORTHERLY HANSEN TRACT BOUNDARY BY HOLDING THIS COMPUTED LOCATION AND THE FOUND UNRECORDED IRON PIPE AT THE NORTHEAST CORNER OF THE HANSEN TRACT. THE NORTHWEST CORNER WAS THEN COMPUTED ON LINE AT A POINT 30.00 FEET EASTERLY OF THE NORTH—SOUTH CENTER OF SECTION 25. I SET REFERENCE POINTS ON—LINE, 15.00 FEET ±EAST AND ±SOUTH OF THIS COMPUTED POSITION AS FURTHER IDENTIFIED HEREON.

THE FOLLOWING DEEDS WERE CONSULTED AS PART OF THIS SURVEY: BOOK 58, PAGE 424, BOOK 58, PAGE 456, BOOK 59, PAGE 385, BOOK 65, PAGE 466, BOOK 65, PAGE 467, BOOK 66, PAGE 481, BOOK 67, PAGE 281, BOOK 74, PAGE 427, M-5942, M-12955, M-15789, M-17344, M-45336, 2001-1371, 2002-6417, & 2015-36478.

ALL PERMANENT BOUNDARY MARKERS WERE SET OR IDENTIFIED, AND THE NORTH LINE OF THE HANSEN TRACT MARKED WITH TEMPORARY STAKES ON MAY 10, 2024. MILLER SUBSEQUENTLY PULLED MANY OF THE STAKES LATER THAT DAY.

THIS SURVEY WAS PERFORMED USING TWO TOPCON HIPER HR GNSS UNITS OPERATED USING RTK METHODS. THE BASIS OF BEARING IS THE EAST—WEST CENTERLINE OF SECTION 25 PER SURVEY FOLDER 829. DISTANCES ARE GROUND, INTERNATIONAL FEET.

LEGEND

HELD 1/4 OR 1/16 CORNER AS REPORTED IN S3.

O HELD 5/8" REBAR WITH YELLOW PLASTIC CAP PER S1.

REFERENCE POINT — SET ON LINE 15.00' FROM TRUE CORNER LOCATION. 5/8" X 30" STEEL REBAR WITH 1-1/4" PINK PLASTIC CAP, MARKED "KENNY LS 89374"

B → HELD 5/8" REBAR PER S1. APPLIED 1-1/4" PINK PLASTIC CAP, MARKED "KENNY LS 89374".

 \otimes COMPUTED LOCATION. NOTHING FOUND OR SET.

△ POINTS MAPPED AT THE REQUEST OF MILLER. SEE NOTES.

— SURVEYED TRACT

-I - APPROXIMATE LOCATION UNDERGROUND IRRIGATION

NARRATIVE AND NOTES.

()# RECORD SURVEY DATA REFERENCE—SEE TABLE

AC. ACRES



P.O. BOX 447, HEPPNER, OR 97836 541-379-0242 www.kennylandsurveying.com

LOCATED IN THE NW 1/4 OF THE SE 1/4 OF SECTION 25, TOWNSHIP 5 NORTH, RANGE 26 EAST, W.M., MORROW COUNTY, OREGON.

CLIENT:

REGISTERED

PROFESSIONAL

LAND SURVEYOR

OREGON JAN 12, 2016

MATTHEW PATRICK KENNY

89374PLS

RENEWS: 6-30-25

ALFRED HANSEN

PROJECT: 2403 DR: MPK CH: MPK DATE: JUNE 11, 2024

RECORDS OF REFERENCE

- S1: GREEN GARDEN ESTATES (SURVEY FOLDER 829), RECORDED 8-31-1995.
- S2: SURVEY FOLDER 198, FILED 9-18-1980.
- S3: PARTITION PLAT NO. 2022-13 (SURVEY FOLDER 1999), RECORDED 7-22-2022. S4: SUBDIVISION OF SECTION 25, SURVEY FOLDER 760, DATED AUGUST, 1906.
- D1: WARRANTY DEED, DOCUMENT #2002-6417, RECORDED 12-31-2002.
- D2: BARGAIN & SALE DEED, M-15789, RECORDED 7-18-1979.
 D3: BARGAIN & SALE DEED, BOOK 74, PAGE 427, RECORDED 4-24-1967.
- D4: BARGAIN & SALE DEED, M-5942, RECORDED 8-15-1973. D5: RIGHT-OF-WAY EASEMENT, BOOK 67, PAGE 281.

RECEIVED BY
Morrow County Surveyor

Date: 7-8-2024 Rec'd By: MPK

No.: 2024 - 2071 C

Folder No.: 2071

SHEET 1 OF 1