## PARTITION PLAT 2025-10 Irrigon, Morrow County, Oregon T. 5N., R. 27E., W.M. Section 19, SW 1/4 of SW 1/4 Block 44, Irrigon City of Irrigon 500 NE Main Street Irrigon, Oregon 97844

Fnd 5/8" Rebar, Origin Unknown 0.30' NE, Did Not Hold

N 76° 05' 25' R6')R6

\$ 76° 34' 19" E 14.63' \$ 75° 45' 20" E 14.67')R3 (C)

Point

S 89° 41' 32" E 66.35'

Parcel 1

9071 Sq. Ft.

**0.21** Acres

N 76° 05' 25" E 133.79')R1 (N 76° 05' 25" E 133.79')R1

**LEGAL DESCRIPTION:** 

Deed 2017-40134 of Morrow County That portion of Lot 6, CLARKS ADDITION, to the City of Irrigon, County of Morrow, and State of Oregon, and of Block 45 of the Town, now City of Irrigon, and of the vacated alleys and vacated Ninth Street, more particularly described as follows: by instrument recorded September 12, 1991, as Microfilm No. M-37282, Microfilm Records of Morrow County; thence North 75° 45' 46" East 14.67 feet along said last-referenced South line to the Southeast Corner of said Cook tract;

Beginning at the Northeast Corner of said Lot 6 Clarks Addition: thence South 0° 25' 53" East 50.00 feet along the East line of said Lot 6 to the most Easterly Southeast corner of said Lot 6; thence North 89° 42' 27" West 20.00 feet along the South line of said Lot 6; thence North 0° 25' 53" West 50.00 feet along a line which is parallel with the East line of said Lot 6 to a Point on the North line of said Lot 6; thence North 89° 42' 27" West 206.30 feet along the South lines of Lots 30 and 11 of Block 45 of the Town, now the City of Irrigon to a Point on the South line of the Tract of land conveyed by John M. Cook and Faye M. Cook, husband and wife, thence North 70.45 feet along the East line of said Cook tract to a point on the centerline of a vacated alley; thence North 76° 05' East 106.96 feet along said centerline to a point which lies South of the Southwest corner of Lot 3 of Block 45 of the Town, now the City of Irrigon; thence South 80.00 feet to a point which lies 210.00 feet South of the North line of said Block 45; thence North 76° 05' East 141.92 feet, more or less, along a line which is parallel with North line of said Block 45 to a point on the centerline of vacated Ninth Street, said point being 210.00 feet South and 30 feet Southwesterly of the Northwest corner of Block 44 of the Town, now N 76° 05' 25" E 547 20' (N 76° 05' 25" E 547 20')R1 Bearing Base City of Irrigon; thence South along the West line of said Block 44 to the Point of Beginning. N 76° 05' 25" E 101 22')R1 (N 76° 05' 25" E 101 22')R1 C.L. Columbia River Highway (Hwy 730)

26.02

[26.00]

SURVEYORS CERTIFICATE & NARRATIVE:

I, Ronald V. McKinnis, being a Registered Professional Land Surveyor of the State of Oregon, certify that I have correctly surveyed and monumented the lands more particularly described in the Legal Description shown hereon according to Oregon Revised Statutes, Chapter 92 of the State of Oregon. The INITIAL POINT of this survey is a 5/8" Rebar with a Yellow Plastic Cap, PLS 951, located at the Southwest

This Survey is Based on a surveys by me for the City of Irrigon, Irrigon Incubator Replat. My Bearing Base is that of Edwards along the Southerly right of way line of U.S. Hwy. #730. I held all of the monments found for the various lots in Edwards' survey and those of adjacent surveys, of which, most were completed by Edwards as well. Having reestablished all of the corners for this legal description for the City of Irrigon, I divided the property as shown into two (2) Parcles. The City intends to immediately convey Parcel 1 to the West Extension Irrigation District who owns Lots 6 & 7 of Block 45. The District intends to combine their lots to alleviate the need to have an easement to this

This survey was conducted with a Trimble R8 RTK Total Station.

## **OWNERS DECLARATION:**

Lot 1

20685 sq. Ft.

0.47 Acres

NOT A PART

Alley (Vacated by Order G-89)

N 76° 06' 54" E 101.33' N 76° 05' 37" E 101.34')R1

Know All Men By These Presents, that owners of the lands shown on this plat do hereby acknowledge that they have caused this Plat to be created, we authorize that this Plat be prepared in accordance with provisions of ORS Chapter 92, and we recognize this Plat as the Official Map and Plat of the Replat as designated by the County Official, and filed in the County of Morrow, State of Oregon.

On this day of \_\_\_\_\_\_\_, 2025, the Mayor of Irrigon appeared personally before me and is known to me to be the identical individual who executed this plat and acknowledged that they did so freely

My Commission Expires October 27, 2026

certify that this is a true and exact copy of the Original Replat as filed for City of Irrigon in Morrow County, Oregon

RECEIVED BY

Morrow County Surveyor

Date 7-21-2025

Rec'd By MPK

No. 2025 - 2105 C

## **LEGEND**

Found Monuments - as Noted

Set 5/8" X 30" Iron Rebar W/ Yellow Plastic Cap, Stamped - P.L.S. #2431

Set PK W/ Washer in Pavement, Stamped - P.L.S. #2431

Calculated Point - Not Set

PARTITION BOUNDARY

Street Center Line

(000)R0 Record - Per Reference Noted


[000] Record - Per Plat of Irrigon

> SCALE 1" = 30 Ft. November, 2024

ENGINEERING - LAND SURVEYING - WATER RIGHTS R. V. McKINNIS ENGINEERING



79980 Prindle Loop Road Hermiston, Oregon 97838 (541) -567-2017

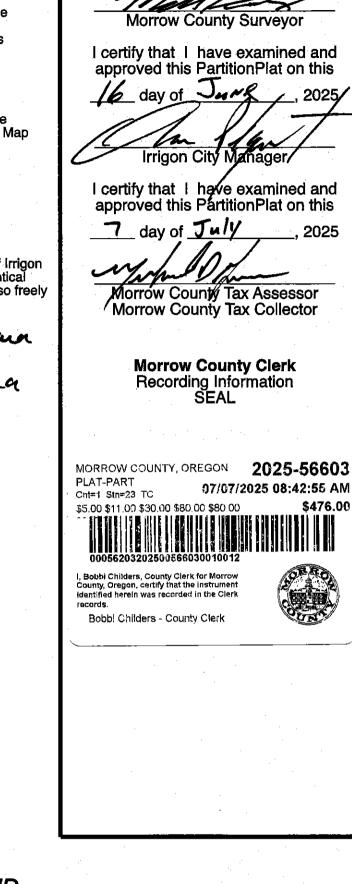

**APPROVALS:** 

I certify that I have examined and approved this PartitionPlat on this

97/07/2025 08:42:55 AM

3 day of July



Rev. 06-10-2025

SCALE 1" = 30 Ft.

**RECORD MONUMENTS:** (A) - Fnd 5/8" Rebar with Plastic Cap, PLS 951, (R1)
(B) - Fnd 5/8" Rebar with Plastic Cap, PLS 951, (R2)
(C) - Fnd 5/8" Rebar with Plastic Cap, PLS 951, (R3)
(D) - Fnd 5/8" Rebar No Cap, PLS 951, (R4)
(E) - Fnd 5/8" Rebar with Plastic Cap, PLS 1094, (R7)
(F) - Fnd 5/8" Rebar with Plastic Cap, PLS 2817, (R5)
(C) - Fnd 5/8" Rebar with Plastic Cap, PLS 2817, (R8) (G) - Fnd 5/8" Rebar with Plastic Cap, PLS 951, (R8)

50.01')R5 206.38' (206.30')R6 RECORD SURVEYS:
R1 - Edwards for Villegas, C.S.#2005-1443-B, Folder 1443, 2005
R2 - Edwards for Schneider, C.S.#2015-1751-C, Schneider Replat, Folder 1751, 2015
R3 - Edwards for Hulse, C.S.#C-1269-E, P.P. 2000-10, Folder 1042, 2010
R4 - Edwards for Barclay, C.S.#C-1126-E, Folder 899, 1997
R5 - Wagner for Clark, C.S.#C-1173-E, Clark Addition, Folder 947, 1998 ≥ : R6 - Deed 2017-40134

S 89° 49' 33" E 140.03'

R7 - Christenson, PLS 1094 - Unrecorded Survey R8 - McKinnis for City of Irrigon, C.S.#2021-1973C, Curloo Estates, Folder 1973, 2021

S 89° 49' 33" E 20.00' (F) (S 89° 42' 27" E 20.00')R5

N 76° 06' 54" E 111.19' (142.92')R6

160.03' (\$ 89° 42' 27" E 160.03')R5

4663 Sq. Ft.

0.11 Acres

N 76° 05' 25" E 94.13')R1

30.00'

oth Street (Vacated by Order

P 24'06" E 21 24'06" E 21

30.001